

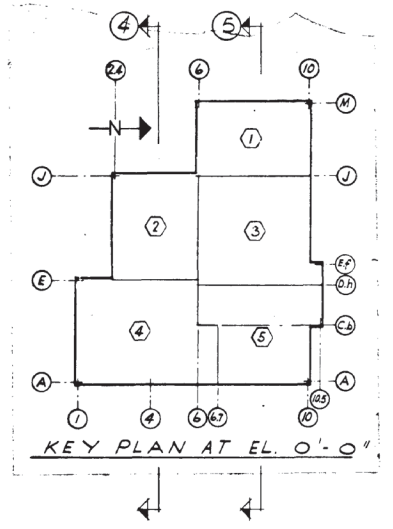
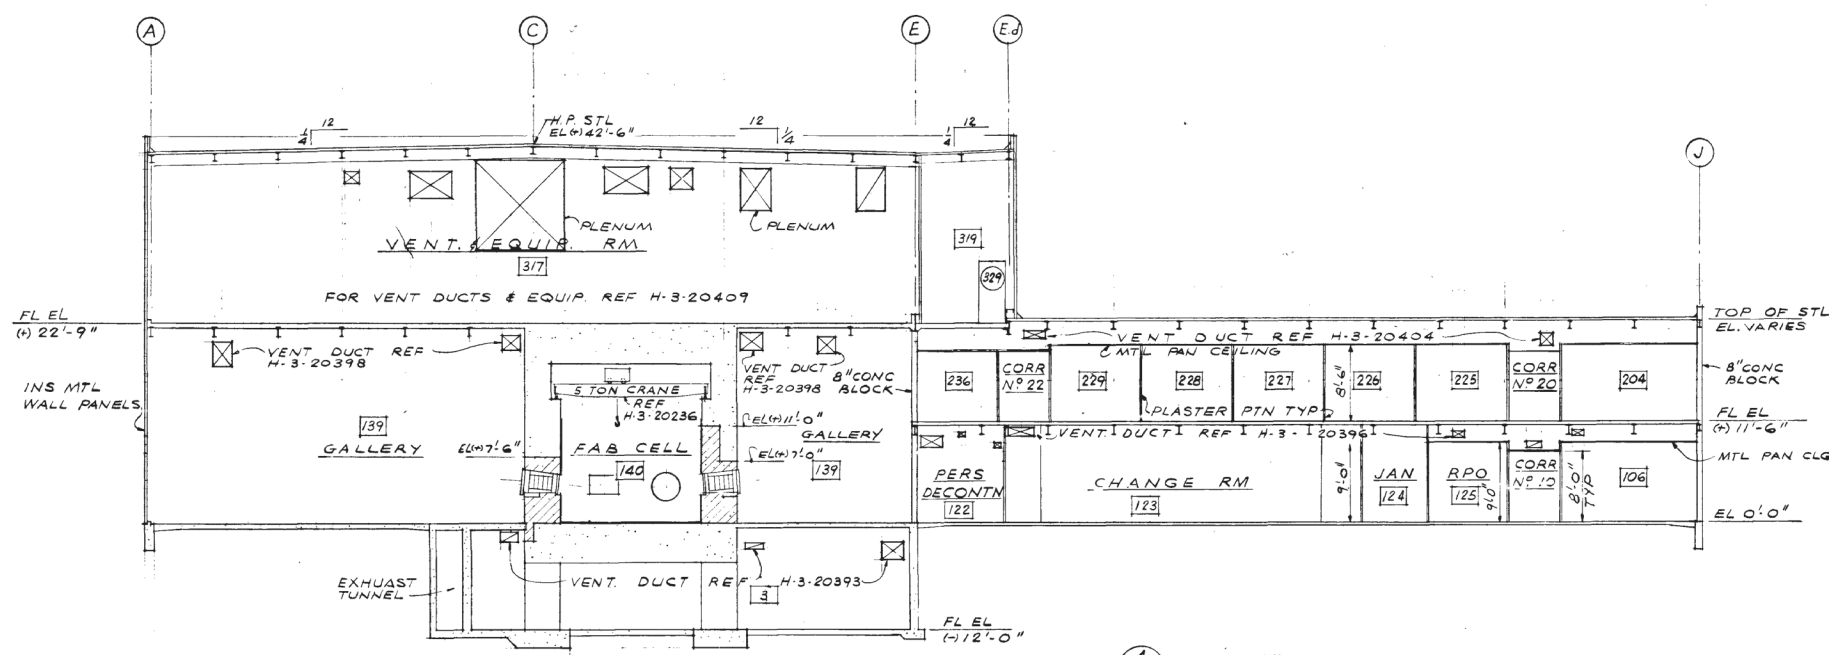


QTY.	PT. NO.	DESCRIPTION
------	---------	-------------

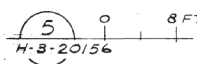

HOT METALLURGICAL CELLS
SST LINER REF H-3-20273,
H-3-20616, G17 & G18

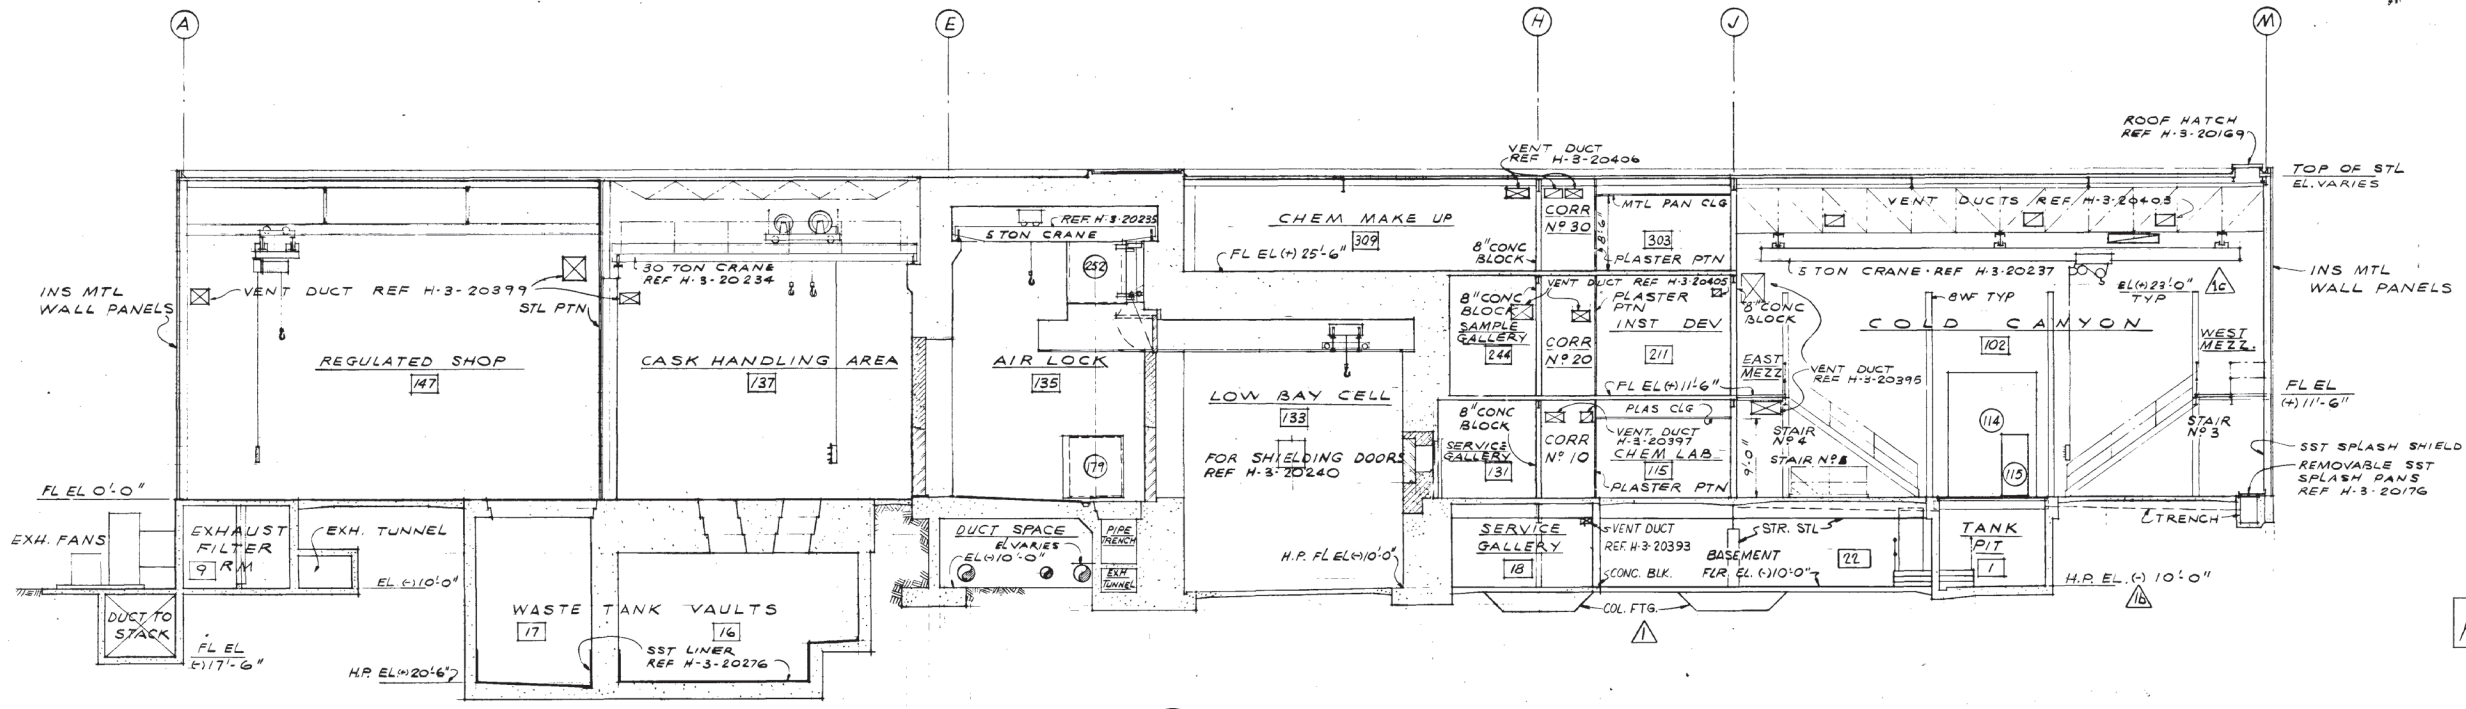

H-3-20178

CHG. SIZE OF DUCT, ZONE II
CHECKED FOR AS-BUILTS
Z.M.F.B. (b) WAS (+) IN F-11
ADDED BASEMENT - SECT 5

NO.	DESCRIPTION	REV. BY	DATE	APP'D BY	FOR	DATE
1		JMJ	3-16-65			

CHECK PRINT	COMMENT PRINT	APPROVED FOR CONST.	U. S. ATOMIC ENERGY COMMISSION HANFORD ATOMIC PRODUCTS OPERATION GENERAL ELECTRIC
DATE: 2-21-64	ISSUE NO: 5	BY: [Signature]	
SCALE AS SHOWN	APPROVED FOR PURCHASE	DATE: 11-6-60	ARCHITECTURAL SECTIONS
DRAWN: [Signature]	BY: [Signature]	DATE: 11-6-60	
CHECKED: [Signature]	APPROVED FOR DESIGN	DATE: 11-6-60	FUELS RECYCLE PILOT PLANT
PROJECT: CAH-916-12479	CLASSIFICATION: NONE	BLDG. NO: 324	INDEX NO: OBC1
DATE: 10/1/61		DWG. NO: H-3-20178	