


QTY.	NO.	DESCRIPTION
------	-----	-------------

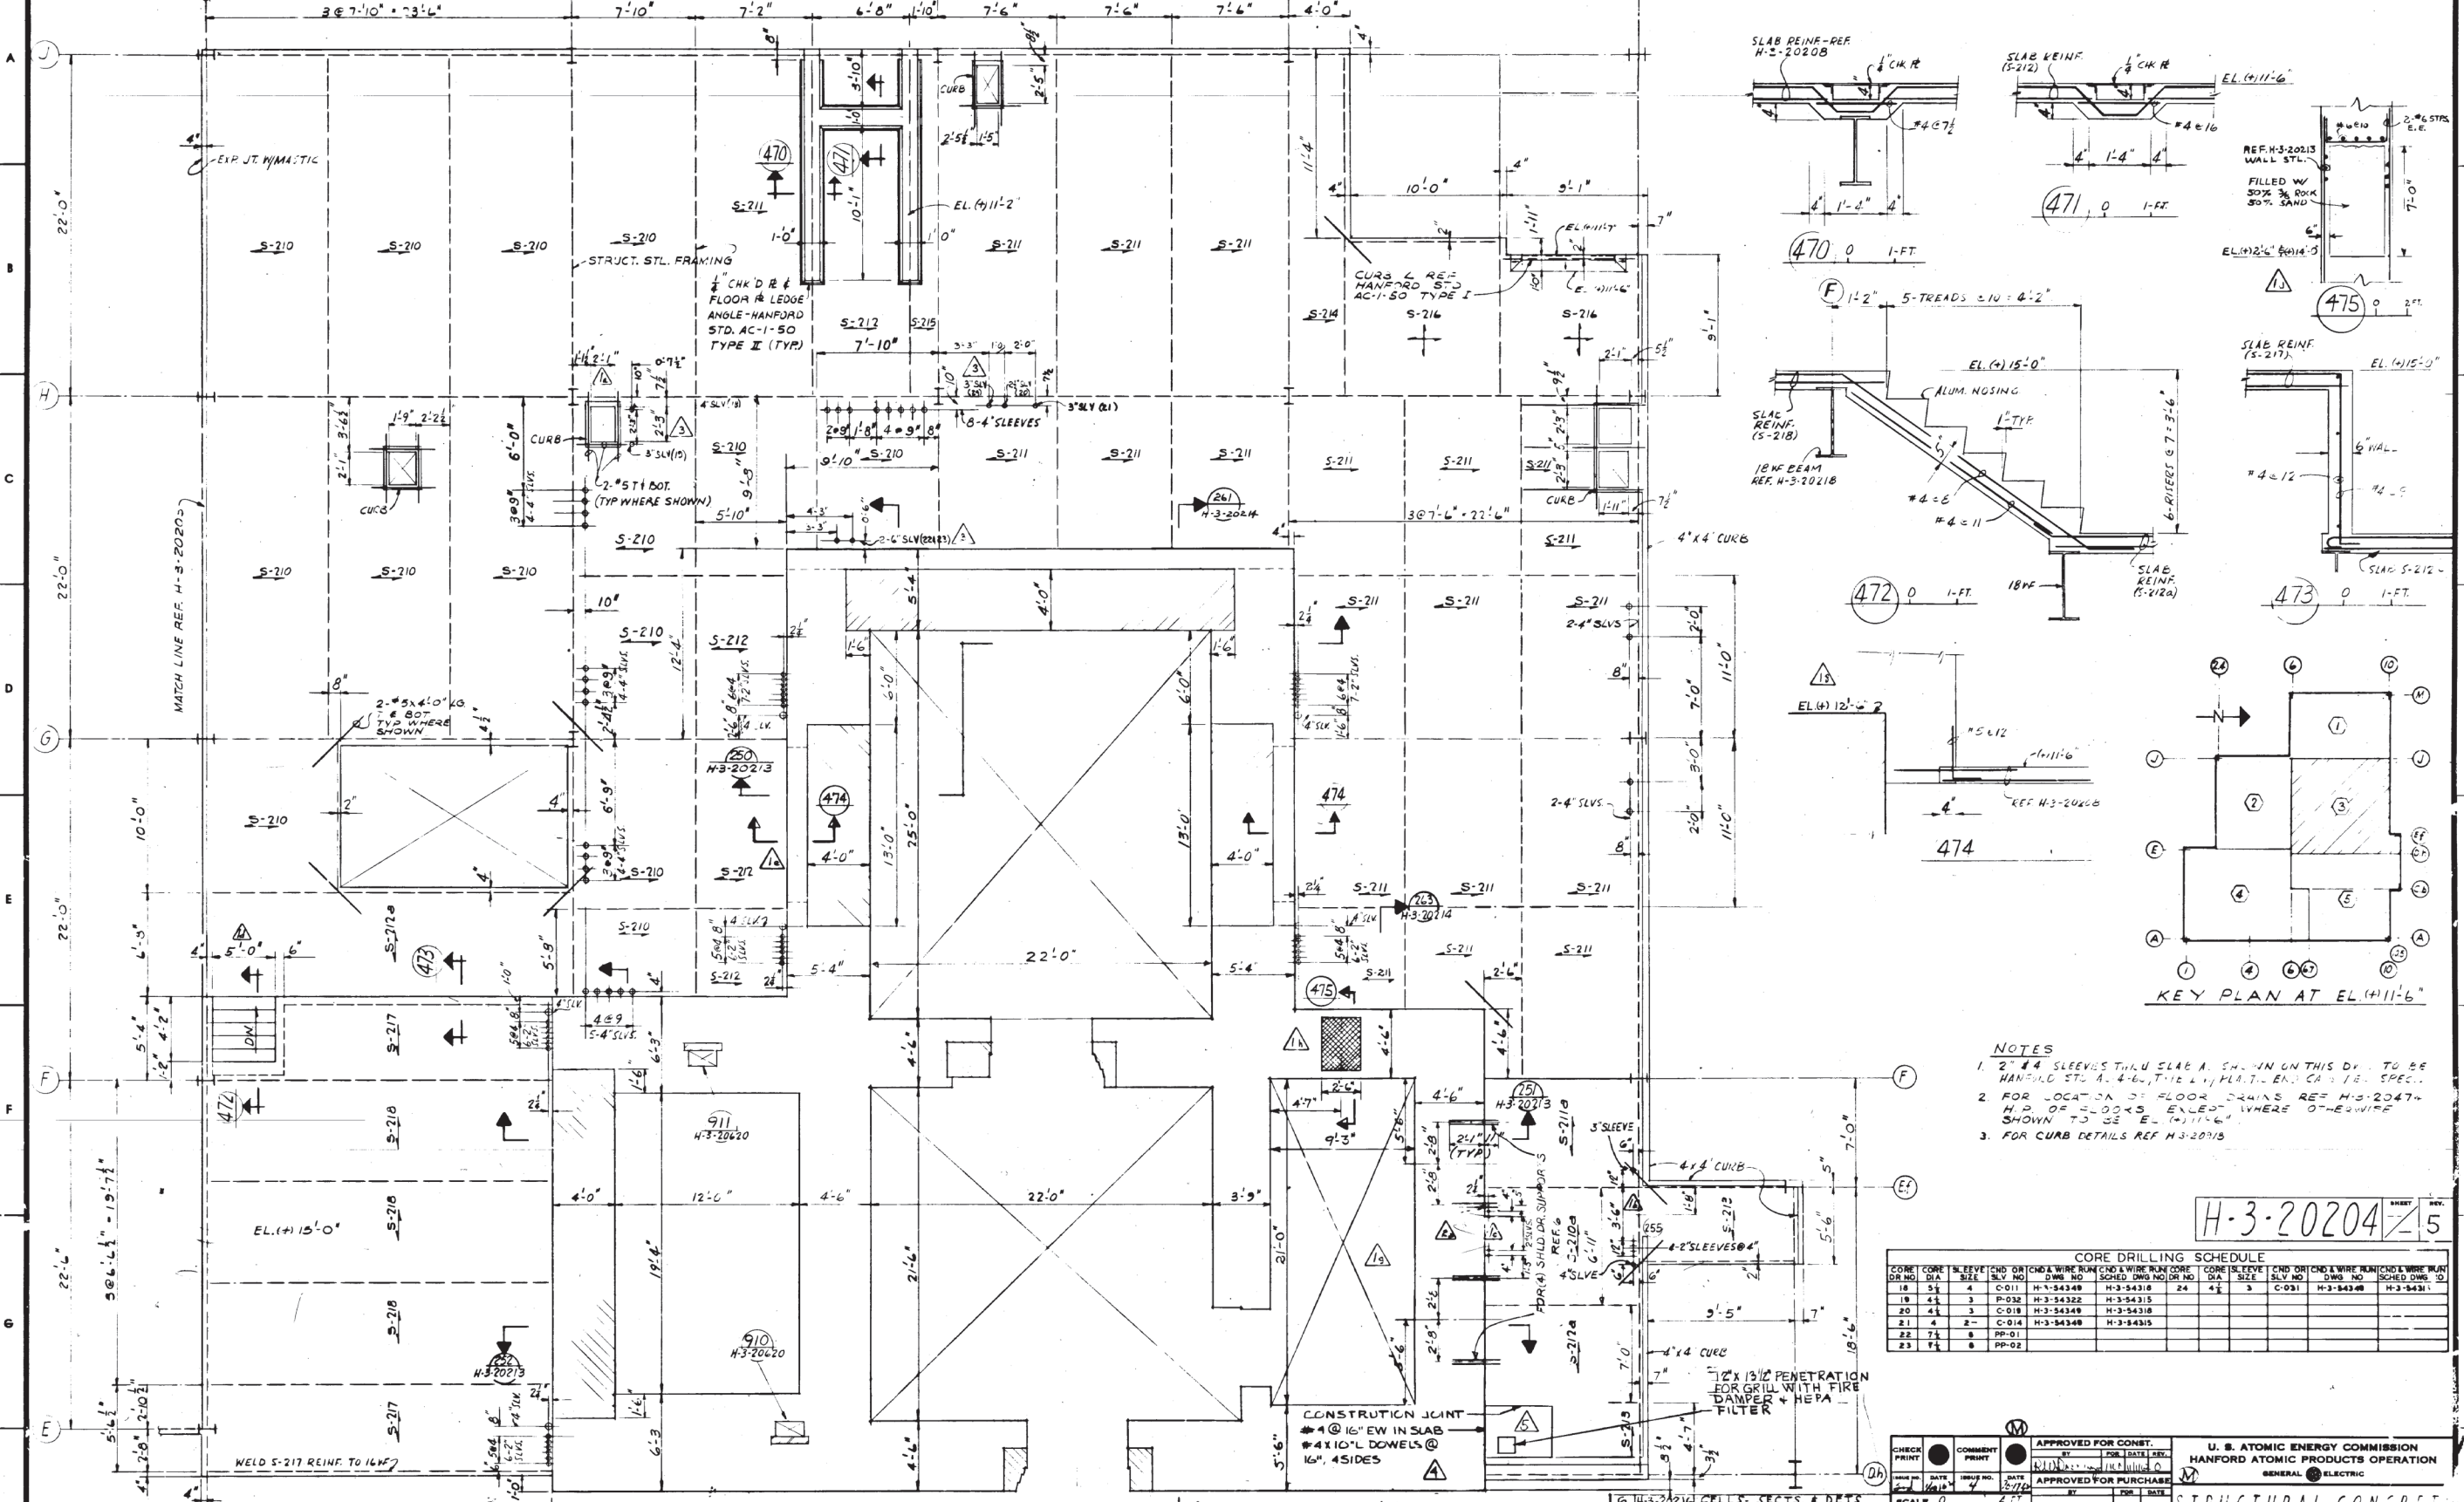

NOTES

- 2" DIA SLEEVES THRU SLAB A. SHOWN ON THIS DRAWING TO BE HANFORD STD. A. 4-6, TYPE 1, PL. 7, EN. CA 150 SPEC.
- FOR LOCATIONS OF FLOOR DRAINS REF H-3-2047 SHOWN TO BE EL (+11'-6") WHERE OTHERWISE SHOWN TO BE EL (+11'-6")
- FOR CURB DETAILS REF H-3-2018

H-3-20204 SHEET 5

CORE DR DIA	SLEEVE SIZE	CHG DR	CHG & WIRE NUM	CHG WIRE CORE	CORE SLY NO	CHG DR DIA	SLEEVE SIZE	CHG DR	CHG & WIRE NUM	CHG WIRE CORE	CORE SLY NO
18	3/4	4	C-011	H-3-54349	H-3-54310	24	4"	3	C-031	H-3-54348	H-3-54311
18	3/4	3	P-032	H-3-54322	H-3-54315						
20	1"	3	C-018	H-3-54349	H-3-54310						
21	4	2	C-014	H-3-54348	H-3-54315						
22	7/8	8	PP-01								
23	7/8	8	PP-02								

CHECKED BY: [Signature] DATE: [Date]	COMMENT: [Text] DATE: [Date]	APPROVED FOR CONST. BY: [Signature] DATE: [Date]	U. S. ATOMIC ENERGY COMMISSION HANFORD ATOMIC PRODUCTS OPERATION GENERAL ELECTRIC
SCALE: 1/4" = 1'-0"		APPROVED FOR DESIGN BY: [Signature] DATE: [Date]	STRUCTURAL CONCRETE PLAN @ (+11'-6") AREA-3
REVISIONS: [List of Revisions]		DRAWING TITLE: H-3-20204 REFERENCE DRAWINGS: [List of References]	FUELS RECYCLE #1177 H-3-20204

NO.	DESCRIPTION	REV. BY	DATE	APP'D BY	DATE
1	AS-BUILT				
2	ADD GRILL ZG9 PER MP				
3	PER MP DOC 2472 Z4-C B-01 RMVD CURB ZNB-G				
4	FILL AREA, ZONE G-B (2) DELETED GRAVEL				