


QTY.	PT. NO.	DESCRIPTION
------	---------	-------------

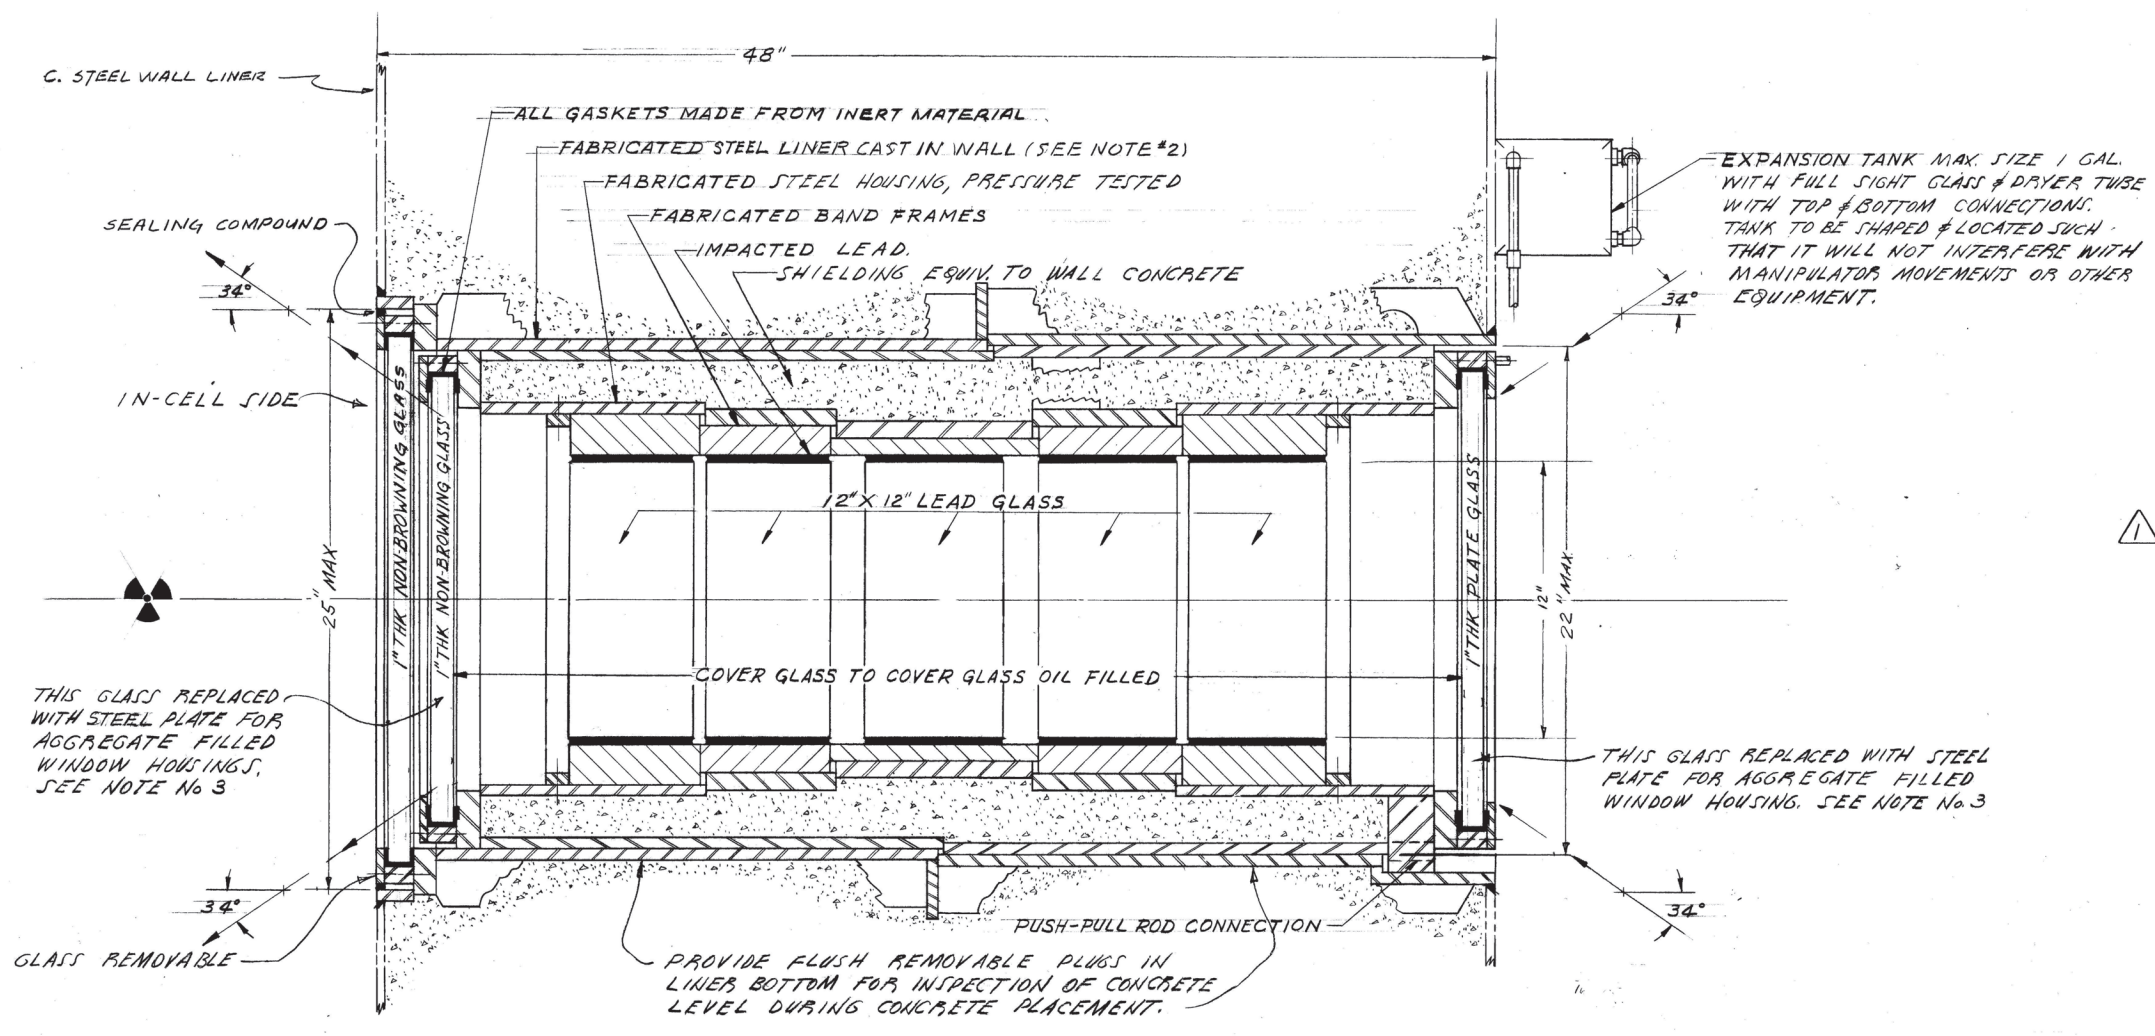

- NOTES:
- (a) WINDOW LINERS WITH HOUSINGS COMPLETE WITH GLASS ARE IDENTIFIED AS EPN 677-1
(b) WINDOW LINERS WITH HOUSINGS FILLED WITH DENSE CONCRETE AGGREGATE HAVE A SUFFIX "A" SUCH AS EPN 677-1A
 - FOR REVIBRATION REQUIREMENTS THAT WILL EFFECT FLUID LOADS ON FRAMES DURING CONCRETE PLACEMENT SEE REF #2.
 - WHERE WINDOW GLASS IS NOT INSTALLED THE HOUSING SHALL BE FILLED WITH DENSE AGGREGATE OF THE MATERIAL AND GRADING AS SPECIFIED FOR HIGH DENSITY CONCRETE BUT WITHOUT CEMENT AS PER REF #2.
 - THIS DRAWING FOR CONTRACTOR DESIGN AND INSTALLATION. SEE REF #2 FOR ADDITIONAL REQUIREMENTS

ELEVATION VIEW IN SECTION
(TYPICAL FOR PLAN VIEW EXCEPT OMIT EXPANSION TANK)

H-3-20247 - 2

NO.	DESCRIPTION	REV. BY	DATE	APP'D BY	FOR	DATE
1	NOTES CHANGED	12479	10-5-62			
2	ADD REF NO 4 ZNGT CHECKED FOR AS-BUILT		5-24-66			

CHECK PRINT	COMMENT PRINT	APPROVED FOR CONST.	BY	FOR	DATE	REV.
ISSUE NO.	DATE	ISSUE NO.	DATE	APPROVED FOR PURCHASE	BY	FOR
2	7-10-62	2	7-10-62			
SCALE NONE		APPROVED FOR DESIGN		U. S. ATOMIC ENERGY COMMISSION HANFORD ATOMIC PRODUCTS OPERATION GENERAL ELECTRIC		
DRAWN	DATE	BY	FOR	DATE	12" SQ VIEWING WINDOW HOT METALLURGICAL CELL	
V.L. BEABERG	3/10/62	H.D. OHW	H.C. PUGH	6/10/62		
CHECKED	DATE	DATE	DATE	FUELS RECYCLE PILOT PLANT		
	3/10/62	3/10/62	6/10/62			
PROJ. NO.	CLASSIFIED BY	CLASSIFICATION	BLDG. NO.	INDEX NO.	DWG. NO.	
CAH-916	12479	NONE	324	5001	H-3-20247	
DATE	NEXT USED ON H-3-20211 & H-3-20212					