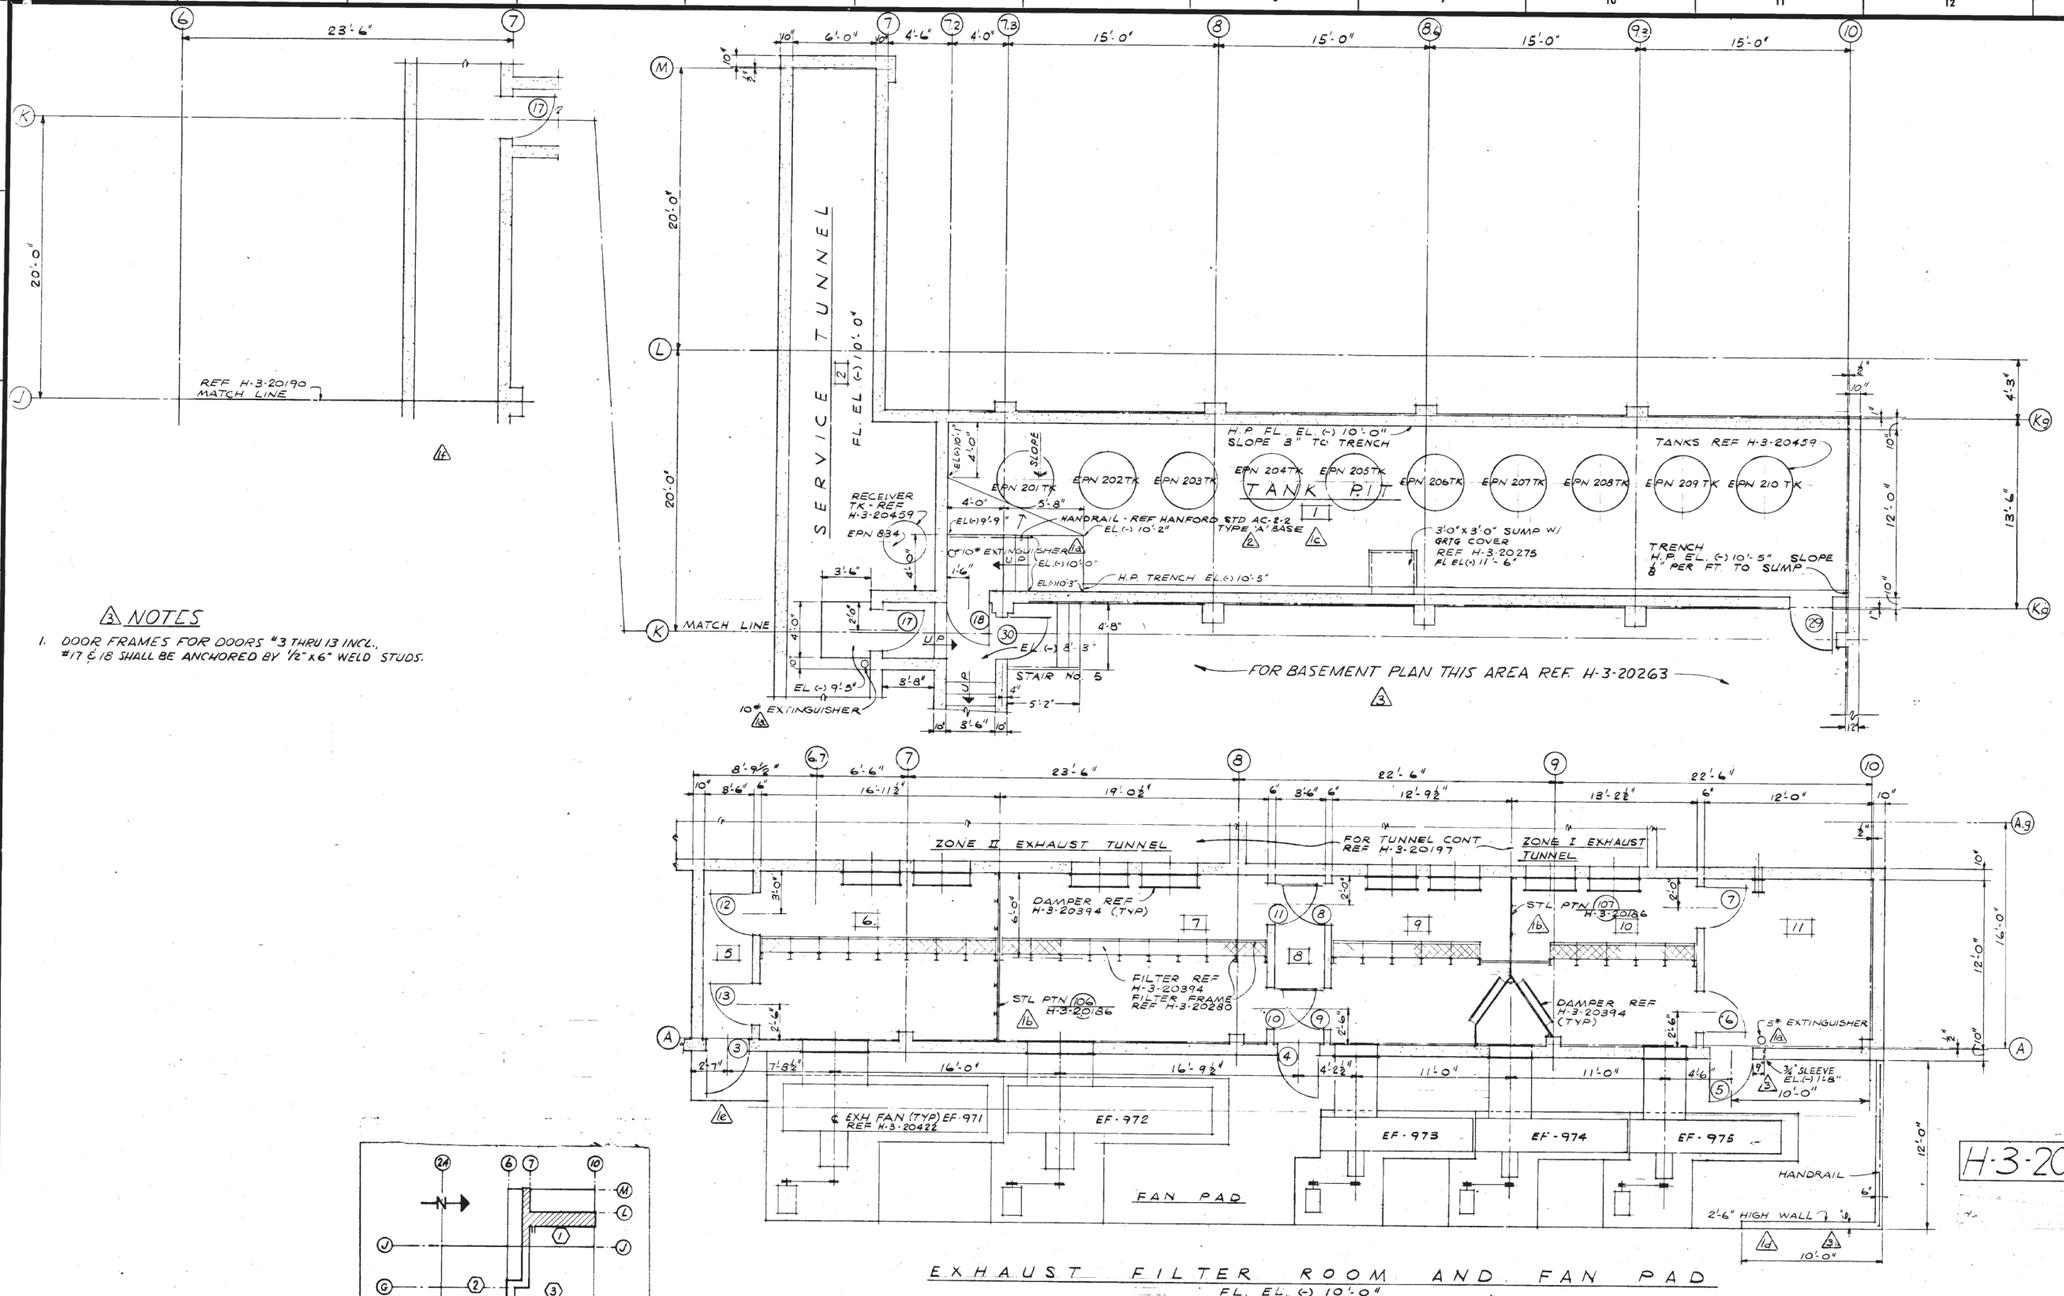

EXHAUST FILTER ROOM AND FAN PAD
FL. EL. (-) 10'-0"

NOTES

1. DOOR FRAMES FOR DOORS #3 THRU 13 INCL., #17 & 18 SHALL BE ANCHORED BY 1/2" x 6" WELD STUDS.

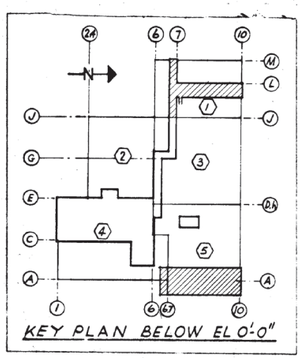

KEY PLAN BELOW EL 0'-0"

NO.	DESCRIPTION	REV. BY DATE	APPD BY	FOR	DATE
3	DELETED SECT. HANDRAIL ADDED SLEEVE, ZN'S, FIL G-11 CHECKED FOR AS-BUILTS ADDED NOTE #1, ZN D-1 REVISED TANK PIT PLAN.	VITRO JMJ 2-11-65	CWL	VITRO	2-11-65
2	ADDED REF. ZONE C-8	JVL 10-25-62	HCK	VITRO CEH	
1	TUNNEL ZONE C-3 PORTION OF SERVICE ZONE F-5 (f) DELETED 9, 11 (b) REVISED CONC. SLAB (d) ADDED CONC. WALL ZONE LINER REF. ZONE C-6 F-1, E-10 (c) DELETED SST. (b) ADDED STL. PTN. REF. ZONE ZONE C-3, D-2, E-11 (a) ADDED FIRE EXTING.	JVL 9-18-62	RWB HCK	HWD CEH	7-19-62 7-20-62

REVISIONS

REF. DWG.	DWG. NO.	DRAWING TITLE
	H-3-20263	BASEMENT PLAN
	AC-2-2	PIPE HANDRAIL - PLATFORMS
	H-3-20156	ARCH KEY PLAN
	H-3-20150	DRAWING LIST

REFERENCE DRAWINGS
NEXT USED ON

CHECK PRINT — COMMENT PRINT
ISSUE NO. — DATE — ISSUE NO. — DATE
SCALE
DRAWN — DATE
CHECKED — DATE
ISSUED — DATE
DES. ENG. — DATE
PROJECT CAM 916 — INST. NO. 12479
CLASSIFIED BY — DATE
CLASSIFICATION: NONE

APPROVED FOR CONST. — BY — FOR — DATE — REV.
APPROVED FOR PURCHASE — BY — FOR — DATE
APPROVED FOR DESIGN — BY — FOR — DATE

U. S. ATOMIC ENERGY COMMISSION
HANFORD ATOMIC PRODUCTS OPERATION
GENERAL ELECTRIC

ARCHITECTURAL
FLOOR PLANS EL(-)10'0"
AREAS 1, 3 & 5

FUELS RECYCLE PILOT PLANT

BLDG. NO. 324 — INDEX NO. 0800
DWG. NO. H-3-20157 — SHT. NO. — CRETS

H-3-20157 — SHEET — REV. 3