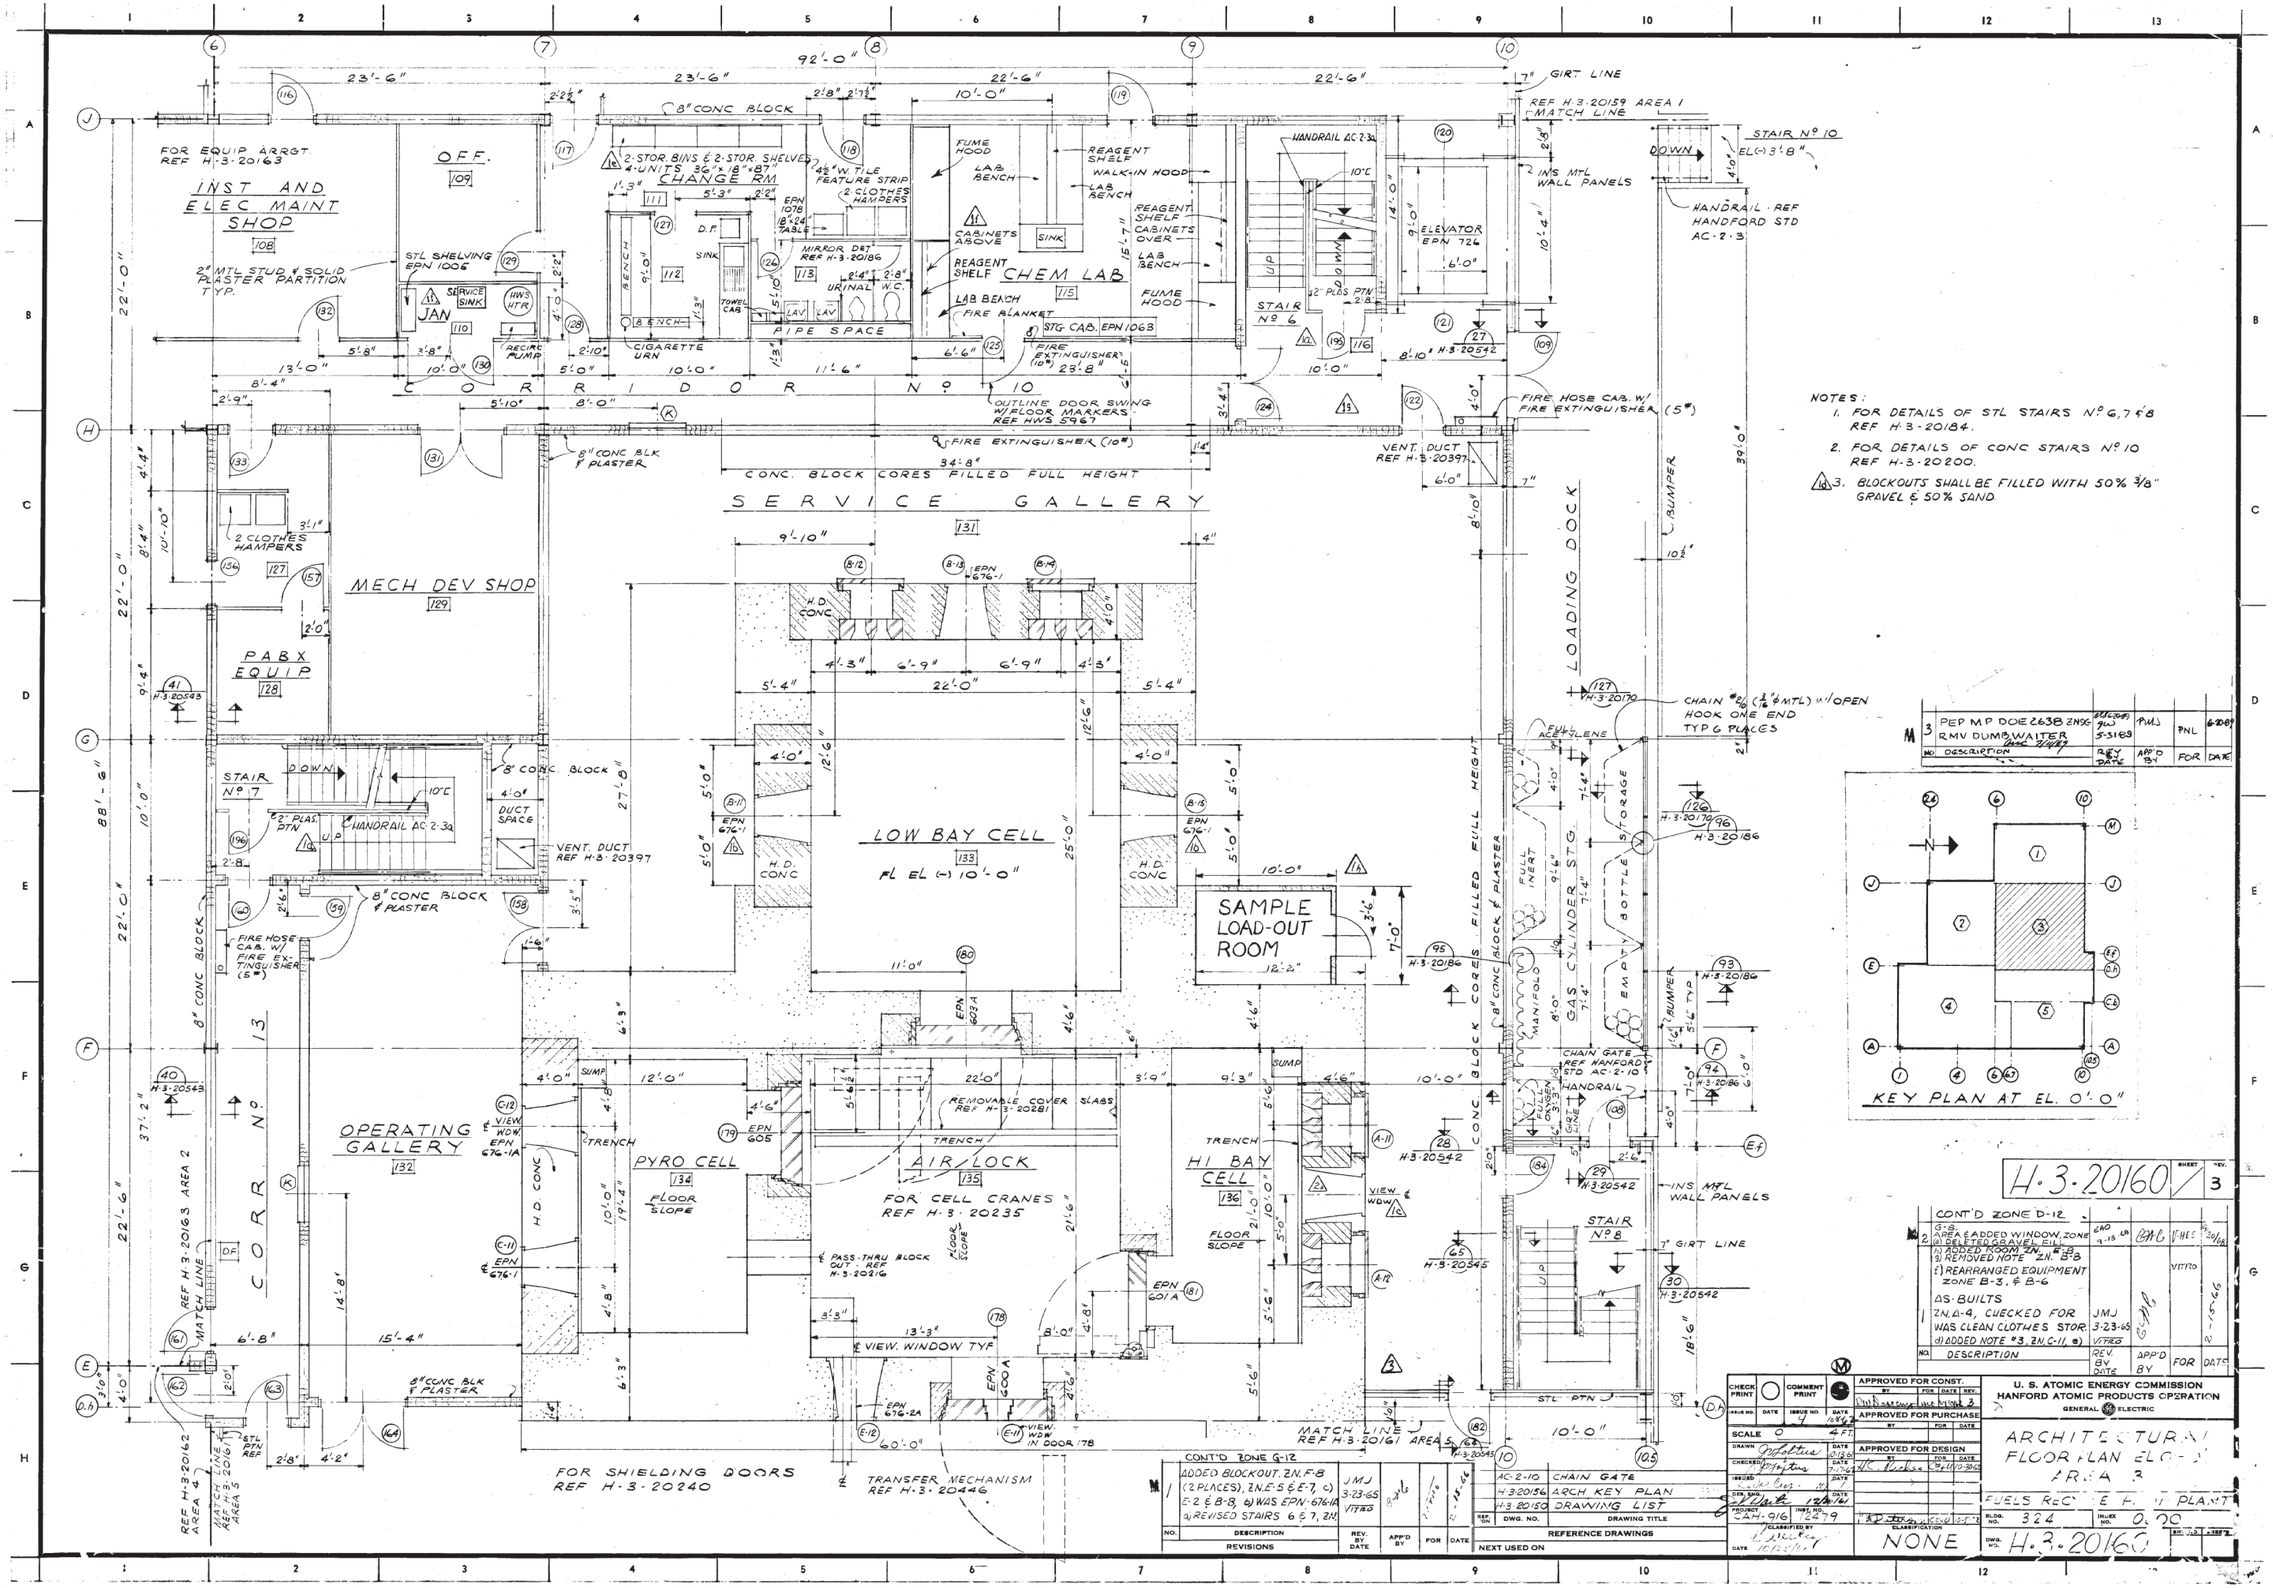

NOTES:

1. FOR DETAILS OF STL STAIRS Nº 6, 7 & 8 REF H-3-20184.
2. FOR DETAILS OF CONC STAIRS Nº 10 REF H-3-20200.
3. BLOCKOUTS SHALL BE FILLED WITH 50% 3/8" GRAVEL & 50% SAND.

NO.	DESCRIPTION	REV. BY DATE	APP'D BY	FOR	DATE
3	PER M.P. DOE 2638 ZN 9C RMV. DUMBWAITER	JMJ 3-31-69	P.W.J.	PNL	6-20-69

NO.	DESCRIPTION	REV. BY DATE	APP'D BY	FOR	DATE
2	CONT'D ZONE D-12. G-8: a) AREA 6 ADDED WINDOW, ZONE b) DELETED GRAVEL, EIL c) ADDED ROOM ZN. E-8 d) REMOVED NOTE ZN. B-8 e) REARRANGED EQUIPMENT ZONE B-3, & B-6 AS-BUILTS ZN. A-4, CHECKED FOR WAS CLEAN CLOTHES STOR. d) ADDED NOTE #3, ZN. C-11, 8	EAG 12-15-65 JMJ 3-23-65 VITRO	GAG JMJ VITRO	VITRO	12-15-66
1	CONT'D ZONE G-12 ADDED BLOCKOUT, ZN. F-8 (2 PLACES), ZN. E-5 & E-7, c) E-2 & B-8, b) WAS EPN-676-1A a) REVISED STAIRS 6 & 7, ZN.	JMJ 3-23-65 VITRO			

NO.	DESCRIPTION
AC-2-10	CHAIN GATE
H-3-20156	ARCH KEY PLAN
H-3-20150	DRAWING LIST

DWG. NO.	DRAWING TITLE

REFERENCE DRAWINGS — NEXT USED ON

CHECK PRINT — COMMENT PRINT — ISSUE NO. — DATE

APPROVED FOR CONST. — APPROVED FOR PURCHASE — APPROVED FOR DESIGN

SCALE 0 4 FT

DRAWN — CHECKED — ISSUED — DR. SUP. — PROJECT SAM-916 — INDEX NO. 1679 — CLASSIFICATION NONE

U. S. ATOMIC ENERGY COMMISSION
HANFORD ATOMIC PRODUCTS OPERATION
GENERAL ELECTRIC

ARCHITECTURAL FLOOR PLAN EL. 0' AREA 3

FUELS RECEIVING PLANT

BLDG. NO. 324 — INDEX NO. 0.00 — DWG. NO. H-3-20160 — REV. 3