| QTY. | PT. NO. | DESCRIPTION |
|---|---|---|

NOTES:

1. FOR DETAILS OF STL STAIRS Nº 6, 7 & 8 REF H-3-20184.
2. FOR DETAILS OF CONC STAIRS Nº 11 REF H-3-20204.
3. BLOCKOUTS SHALL BE FILLED WITH 50 % ⅜ GRAVEL AND 50 % SAND.
4. INSTALL ¼" BUTYL RUBBER FILLER OR APPROVED EQUAL AND CAULK THE VERTICAL CENTER GROOVES IN EACH METAL WALL PANEL, FLOOR TO CEILING.

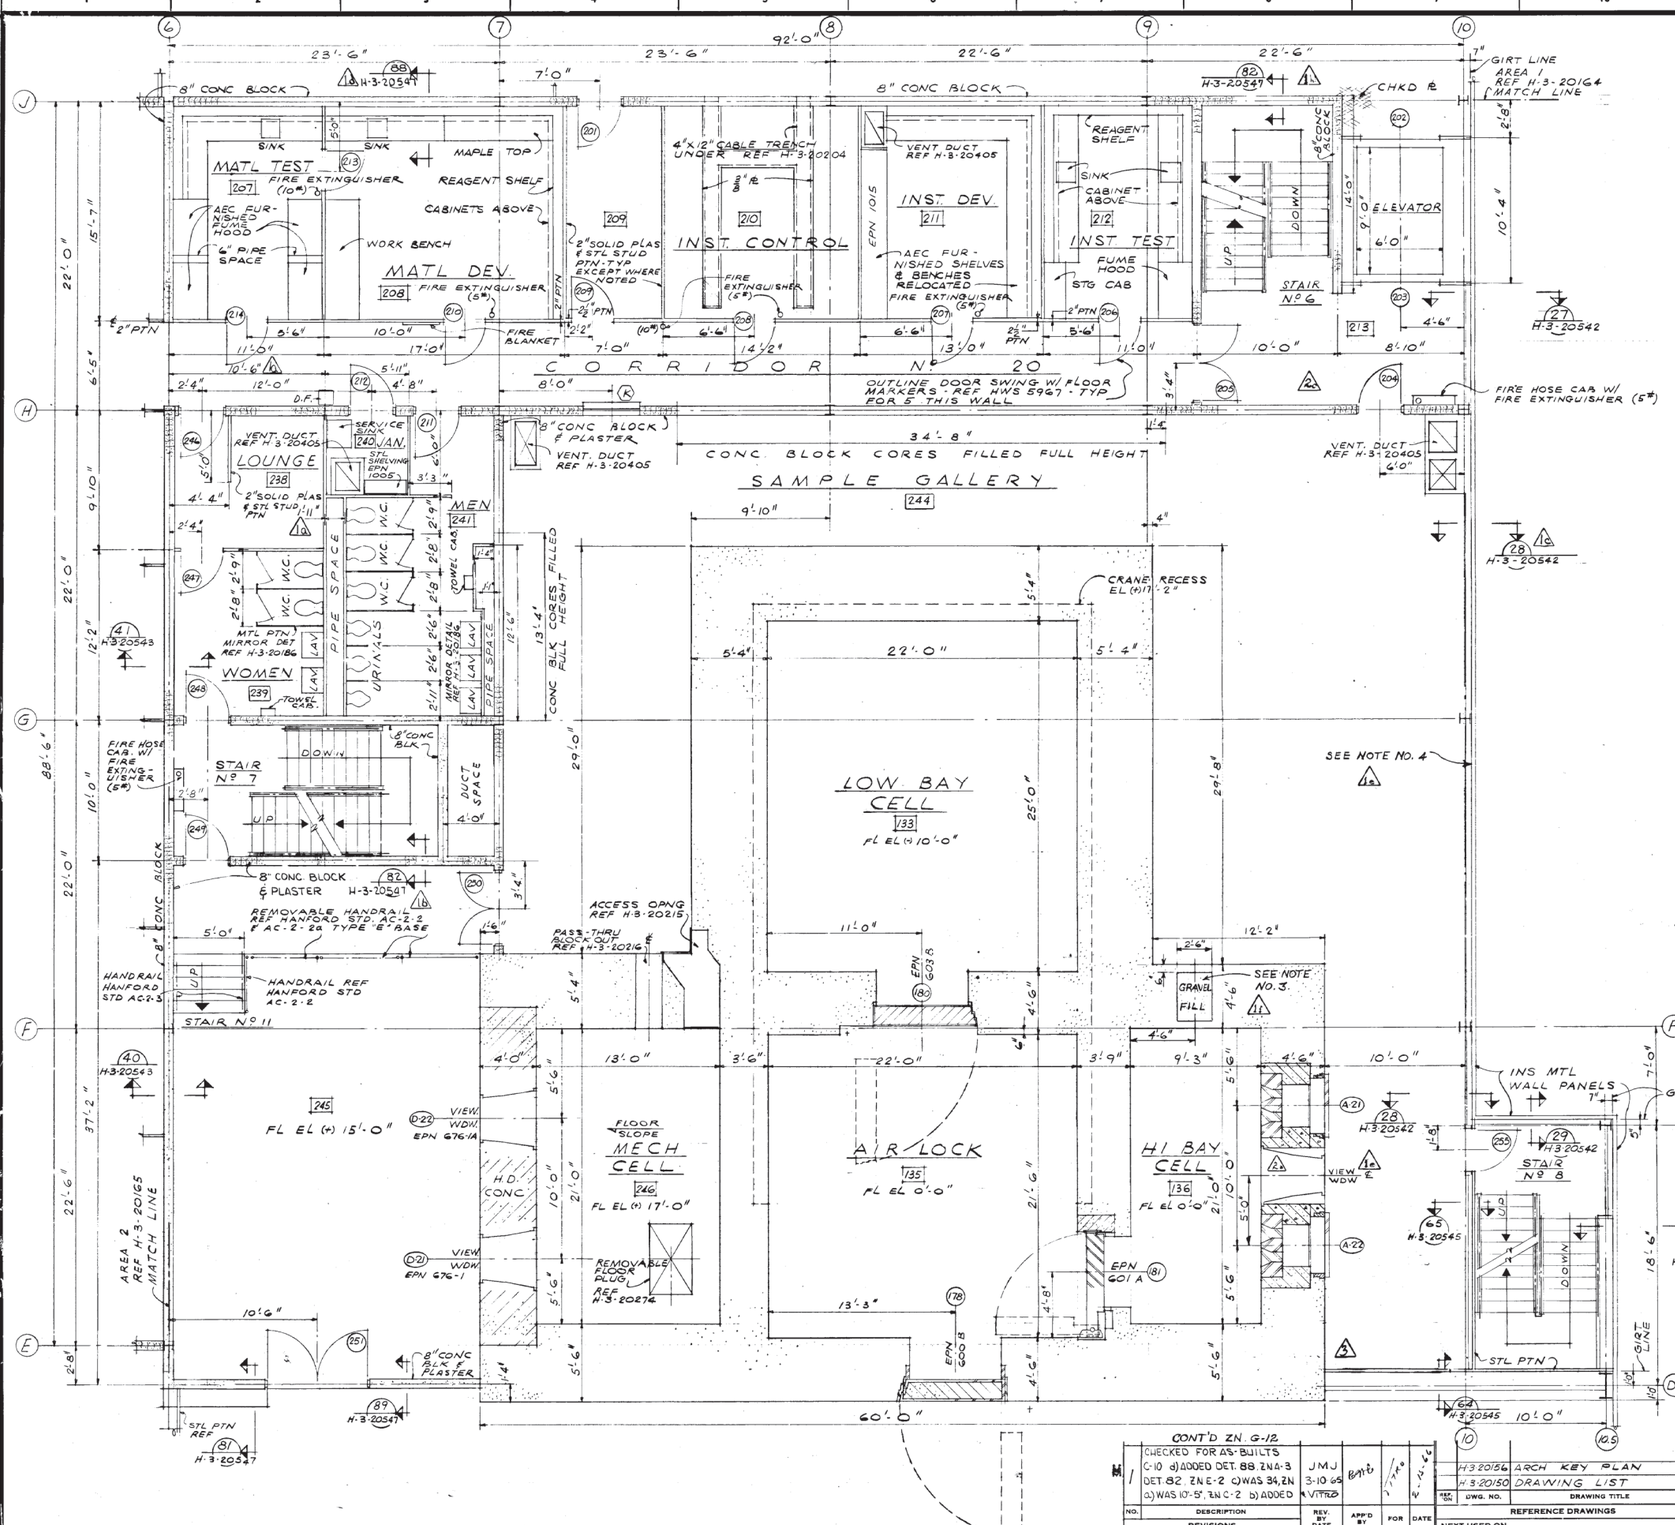


| NO. | DESCRIPTION | REV. BY DATE | APP'D BY | FOR | DATE |
|---|---|---|---|---|---|
| 3 | MP DOB 26-38 ZN B-6 RMV DUMB WAITER PER Dwg 20167 | | | | |
| 2 | ADDED WINDOW ZONE G-8 a) DELETED GRAVEL FILL 2 | EAO 4-19-66 | | | |
| 1 | k) ADDED NOTE No. 4 ZN B-11 i) ADDED NOTE No. 3 ZN. A-11 b) ADDED DET. 82 ZN. A-8 g) DELETED NOTE ZN. E-8 f) ADDED GRAVEL FILL ZN. F-8 e) ADDED DIM & NOTE ZN. G-8 | EAO JMJ 3-10-65 VITAG | | | |

REVISIONS

CONT'D ZN. G-12

| NO. | DESCRIPTION | REV. BY DATE | APP'D BY | FOR | DATE |
|---|---|---|---|---|---|
| 1 | CHECKED FOR AS-BUILTS C-10 d) ADDED DET. 88. ZN A-3 DET. 82. ZN E-2 c) WAS 34, ZN c.) WAS 10'-5", ZN C-2 b) ADDED | JMJ 3-10-65 VITAG | | | |

REVISIONS

| REF. DWG. | DWG. NO. | DRAWING TITLE |
|---|---|---|
| | H-3-20156 | ARCH KEY PLAN |
| | H-3-20150 | DRAWING LIST |

REFERENCE DRAWINGS

NEXT USED ON

CHECK PRINT | COMMENT PRINT

| ISSUE NO. | DATE | ISSUE NO. | DATE |
|---|---|---|---|
| | | | |

SCALE 0 4 FT.

| | | DATE |
|---|---|---|
| DRAWN | | |
| CHECKED | | |
| ISSUED | | |
| SEN. ENG. | | |
| PROJECT ENG. | CAM-916 | INST. NO. 12479 |

CLASSIFIED BY

DATE

APPROVED FOR CONST. — BY / FOR / DATE / REV.

APPROVED FOR PURCHASE — BY / FOR / DATE

APPROVED FOR DESIGN — BY / FOR / DATE

CLASSIFICATION: NONE

U. S. ATOMIC ENERGY COMMISSION
HANFORD ATOMIC PRODUCTS OPERATION
GENERAL ELECTRIC

ARCHITECTURAL
FLOOR PLAN EL 11'-6"
AREA 3

FIELDS RECYCLE PILOT PLANT

BLD. NO. 324 — 05-01

DWG. NO. H-3-20166 — SHT. NO. / SHEETS — REV. 3

H-3-20166 / SHEET / REV. 3