QTY.	PT. NO.	DESCRIPTION

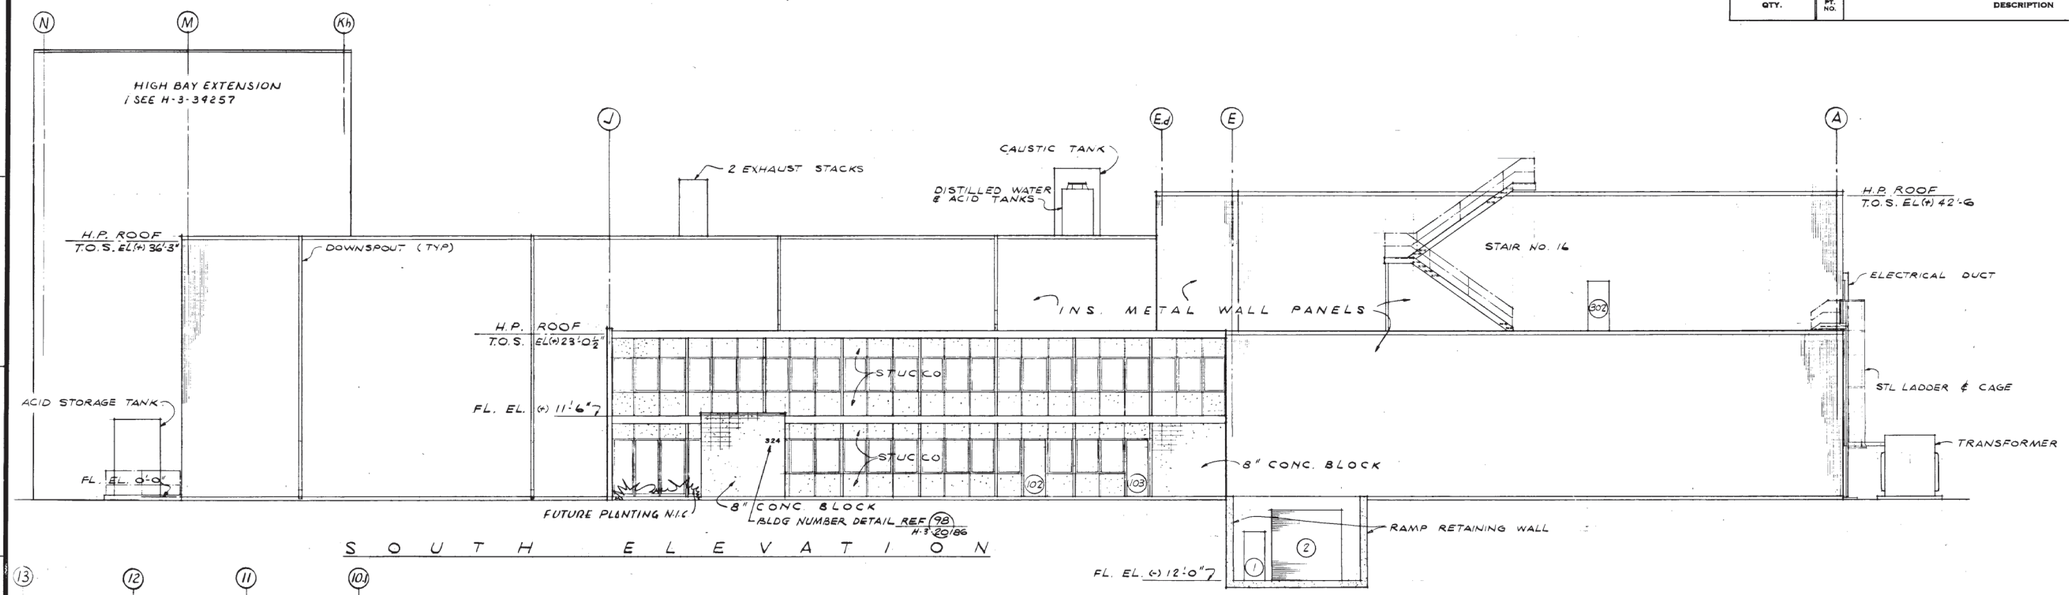

S O U T H E L E V A T I O N

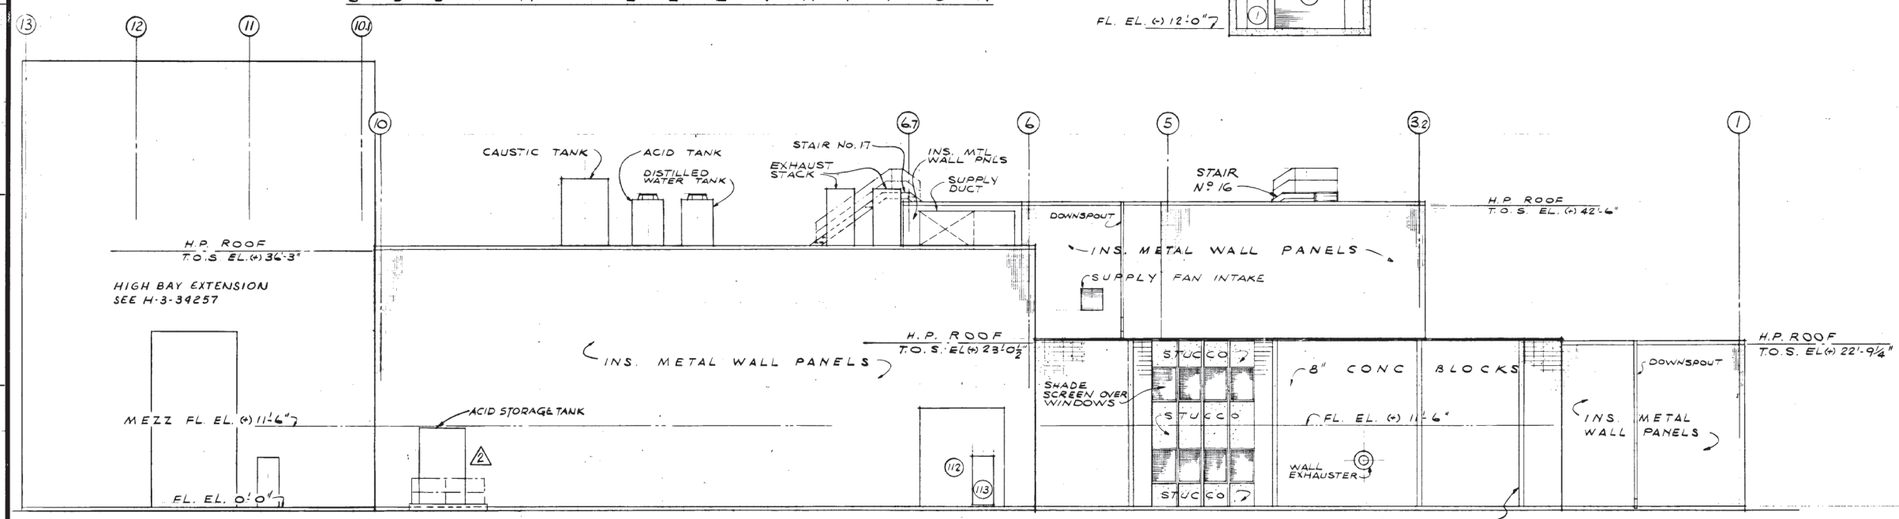

W E S T E L E V A T I O N

H-3-20180 SHEET / REV. 2

NO.	DESCRIPTION	REV. BY DATE	APP'D BY	FOR	DATE
2	DWG #2 PER MP ERDA-1603 ADDED HIGH BAY EXT & REF. RELOCATED ACID TANK #1 & #2 PER MOD PERM.T DOE 1756	3/30/79		P N L	3/13/81
1	CHECKED FOR AS-BUILTS	JMJ 3-22-65		1/1780	5/1/81

REVISIONS

REFERENCE DRAWINGS		
NEXT USED ON	DWG. NO.	DRAWING TITLE
	2 H-3-34257	SITE PL & DWG LIST
	1 H-3-20150	DRAWING LIST

CHECK PRINT | COMMENT PRINT | ISSUE NO. | DATE | ISSUE NO. 3 | DATE 9/16

SCALE 0 6 FT

DRAWN | CHECKED | ISSUED | DWG. APP'D | PROJECT CAM 916 | INSTN NO. 12279

CLASSIFICATION: NONE

APPROVED FOR CONST. | APPROVED FOR PURCHASE | APPROVED FOR DESIGN

U. S. ATOMIC ENERGY COMMISSION
HANFORD ATOMIC PRODUCTS OPERATION
GENERAL ELECTRIC

ARCHITECTURAL
SOUTH & WEST
ELEVATIONS

FUELS RECYCLE PILOT

BLDG. NO. 324 | INDEX NO. 080

DWG. NO. H-3-20180 | SHT. NO. | REV. 2