QTY.	PT. NO.	DESCRIPTION

NOTES:
1. FOR DETAILS OF STL STAIRS Nº 6 REF H-3-20184
2. FOR DETAILS OF CONC STAIRS Nº 7 REF H-3-20195 & H-3-20184.

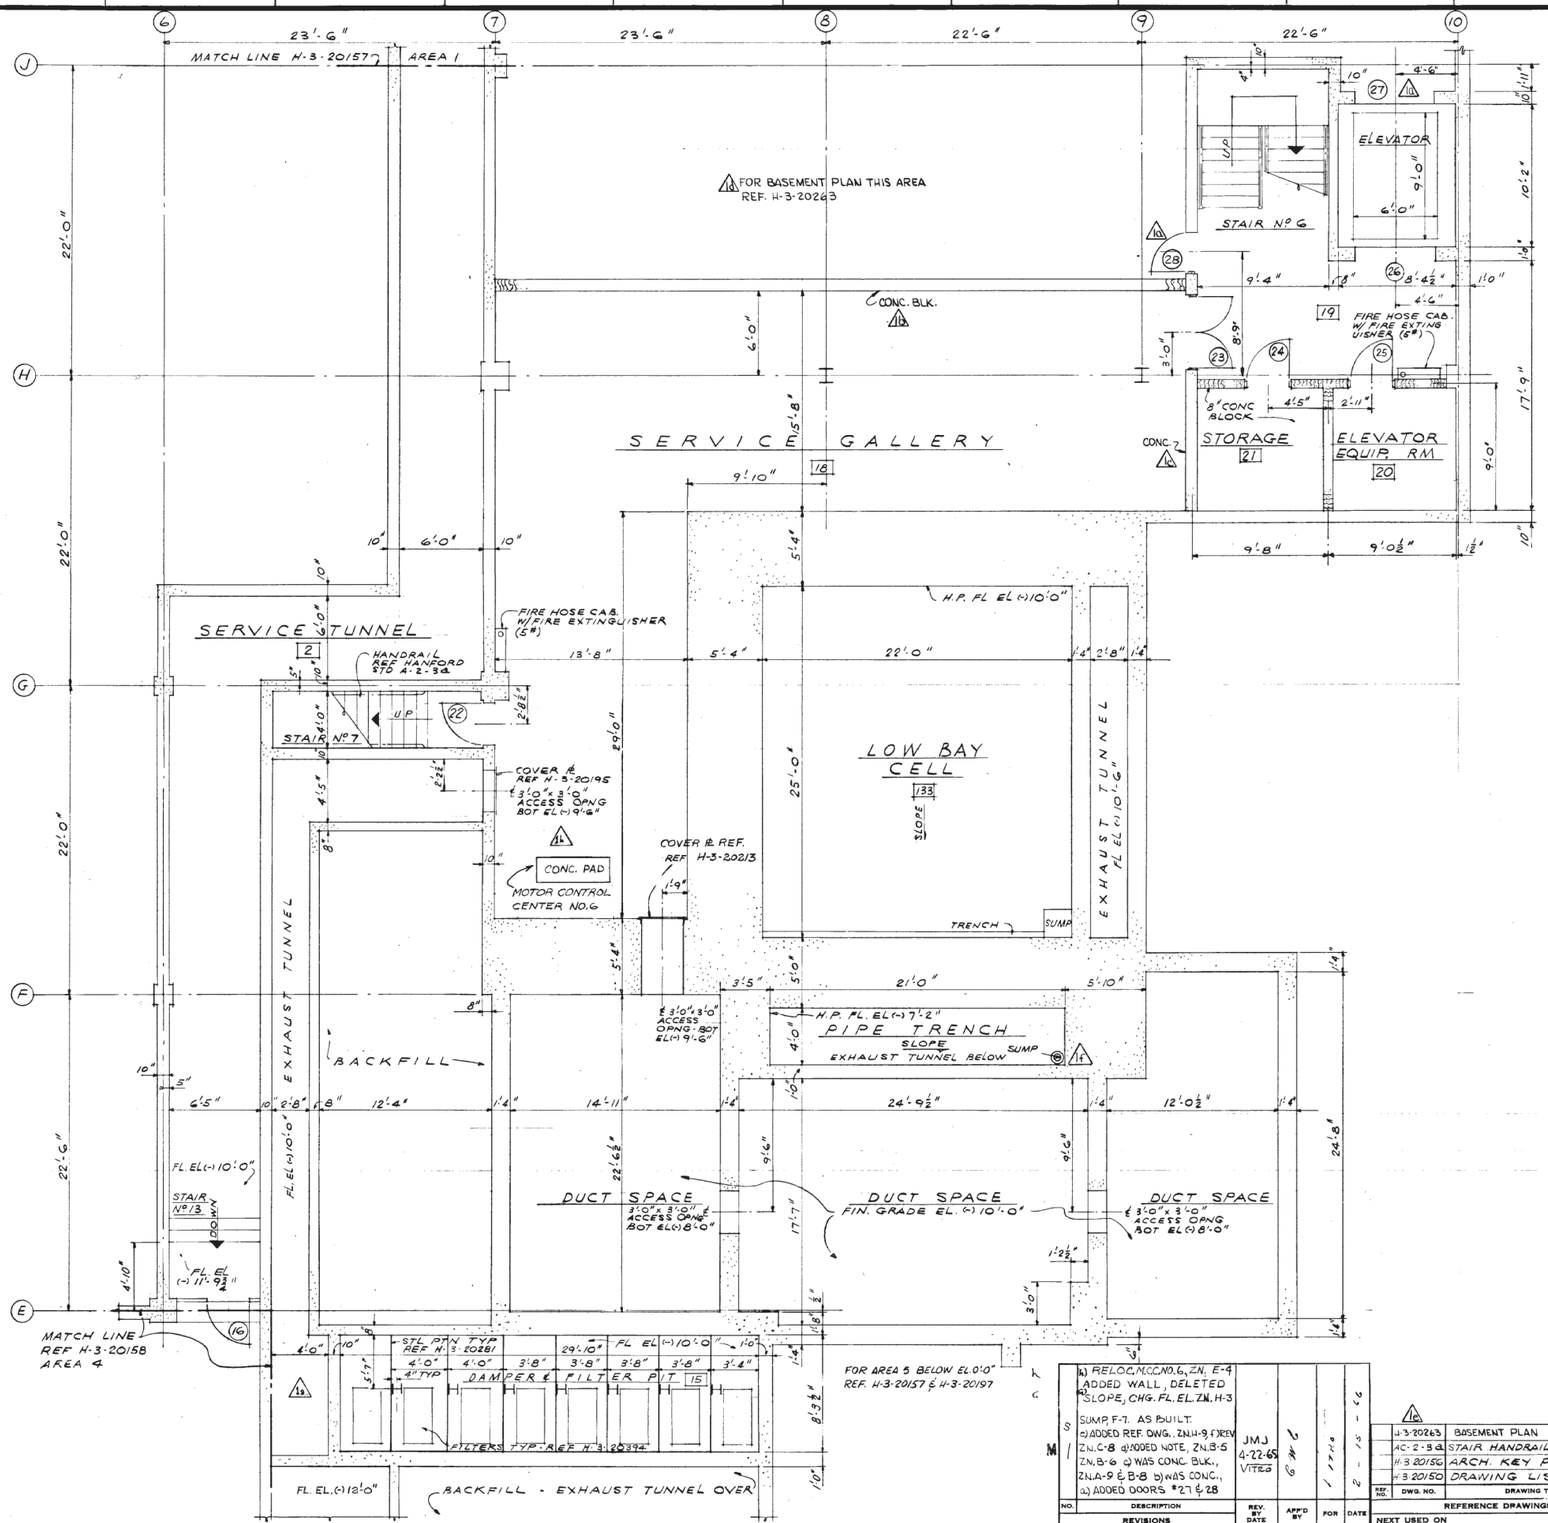

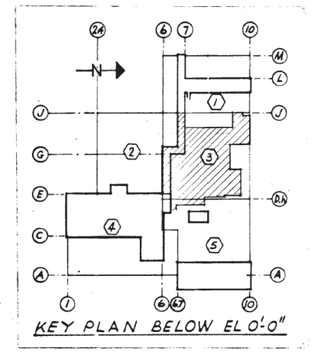

H-3-20190 | SHEET | REV. 1

NO.	DESCRIPTION	REV. BY DATE	APP'D BY	FOR	DATE
	REVISIONS				
4)	RELOC. M.C.C. NO. 6, ZN. E-4 ADDED WALL, DELETED SLOPE, CHG. FL. EL. ZN. H-3	JMJ 4-22-65 VITEO		1	12-20
3)	SUMP, F-7. AS BUILT. c) ADDED REF. DWG., ZN. H-9, f) REV ZN. C-8 d) ADDED NOTE, ZN. B-5 ZN. B-6 e) WAS CONC. BLK., ZN. A-9 & B-8 b) WAS CONC., a) ADDED DOORS #27 & 28			2	12-15-66

REV. NO.	DWG. NO.	DRAWING TITLE
H-3-20263		BASEMENT PLAN
AC-2-3a		STAIR HANDRAIL - WALL MTD.
H-3-20150		ARCH. KEY PLAN
H-3-20150		DRAWING LIST

REFERENCE DRAWINGS

NEXT USED ON

CHECK PRINT	COMMENT PRINT
ISSUE NO. / DATE	ISSUE NO. / DATE

SCALE 0 — 4 FT.

DRAWN		DATE
CHECKED		DATE
ISSUED		DATE
APP'D		DATE
PROJECT	INDEX NO.	
CAH-816	12479	

SUBMITTED BY: DATE 8/12/65

APPROVED FOR CONST.			
BY	FOR	DATE	REV.

APPROVED FOR PURCHASE		
BY	FOR	DATE

APPROVED FOR DESIGN		
BY	FOR	DATE

CLASSIFICATION: NONE

U. S. ATOMIC ENERGY COMMISSION
HANFORD ATOMIC PRODUCTS OPERATION
GENERAL ELECTRIC

ARCHITECTURAL FLOOR PLAN EL (-) 10'-0" AREA 3

FUELS RECYCLE PILOT PLANT

BLDG. NO. 324 | INDEX NO. 0800

DWG. NO. H-3-20190 | SHT. | SHEETS