QTY.	PT. NO.	DESCRIPTION

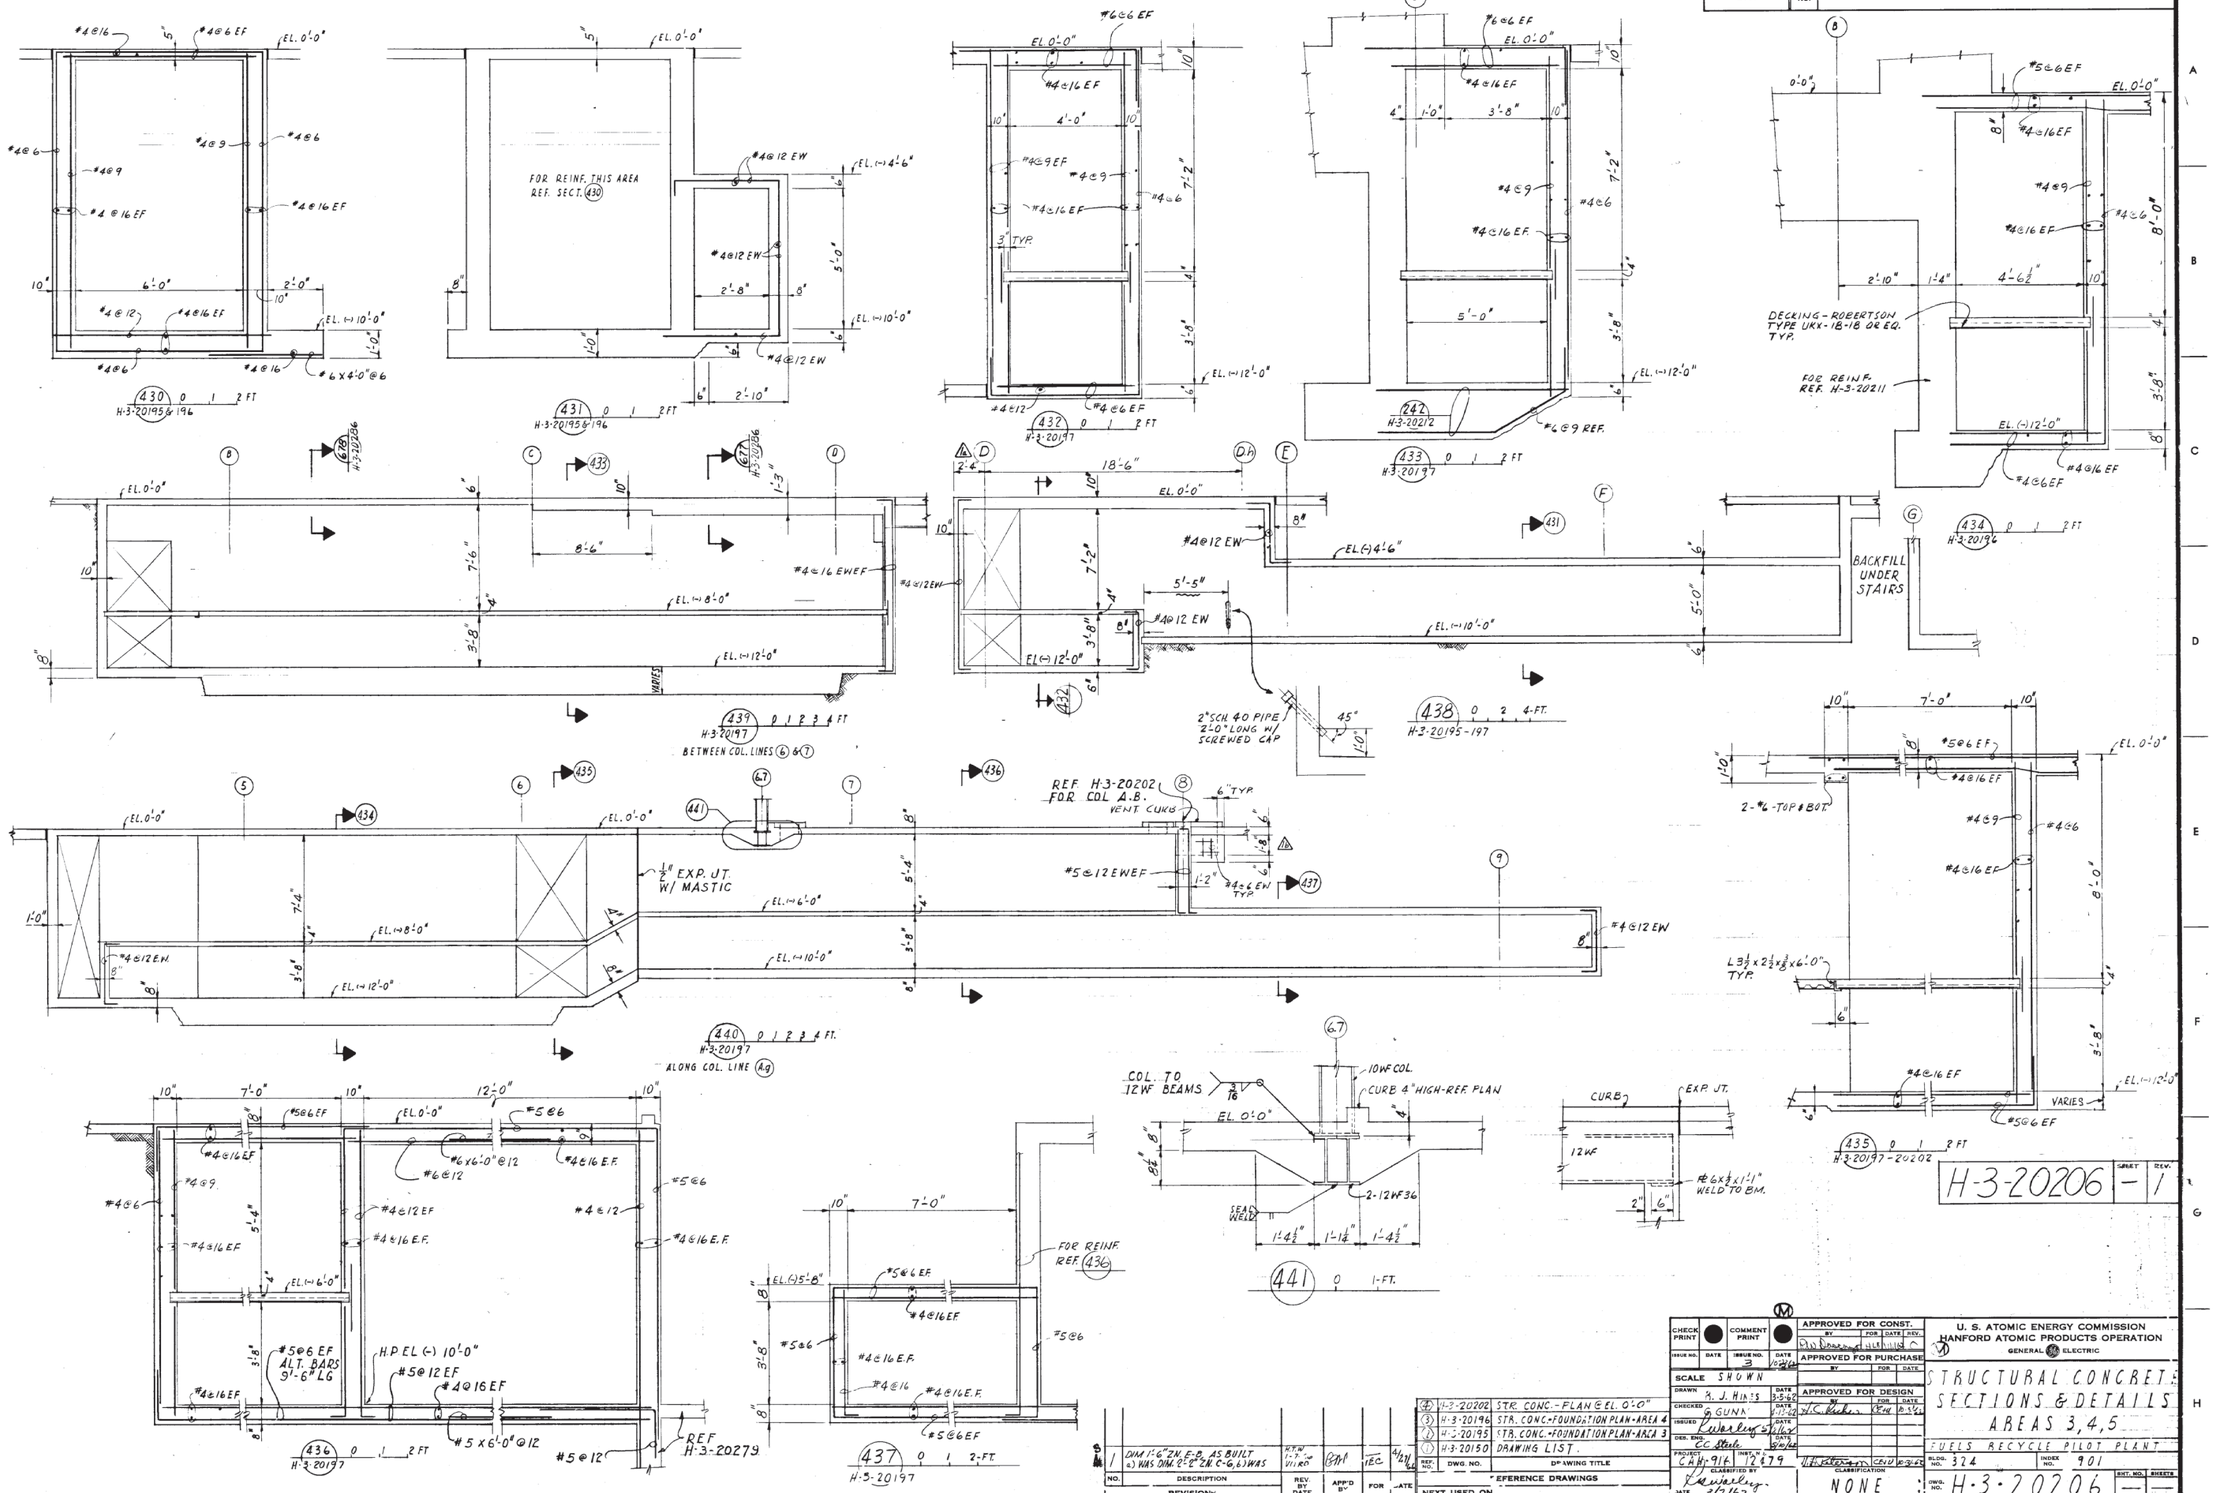

CHECK PRINT	COMMENT PRINT	
ISSUE NO.	DATE	ISSUE NO. 3 DATE 10-24-66

APPROVED FOR CONST. BY | FOR | DATE | REV.
APPROVED FOR PURCHASE BY | FOR | DATE
APPROVED FOR DESIGN BY | FOR | DATE

SCALE SHOWN

DRAWN A. J. HINES DATE 3-5-66
CHECKED G. GUNN DATE 7-27-66
ISSUED DATE 10-24-66
DES. ENG. DATE
PROJECT CAH-916 INST'N 12679
CLASSIFIED BY DATE 8/7/67
CLASSIFICATION NONE

U. S. ATOMIC ENERGY COMMISSION
HANFORD ATOMIC PRODUCTS OPERATION
GENERAL ELECTRIC

STRUCTURAL CONCRETE SECTIONS & DETAILS AREAS 3, 4, 5

FUELS RECYCLE PILOT PLANT

BLDG. NO. 324 INDEX NO. 901 DWG. NO. H-3-20206 SHT. NO. — SHEETS —

NO.	DESCRIPTION	REV. BY DATE	APP'D BY	FOR	DATE
1	DIM 1'-6" ZN. E-D, AS BUILT a) WAS DIM. 2'-2" ZN. C-G, b) WAS	H.T.W. 11-7-66 V1180			4/21/66

REVISIONS

REF. NO.	DWG. NO.	DESCRIPTION
4	H-3-20202	STR. CONC. - PLAN @ EL. 0'-0"
3	H-3-20196	STR. CONC. - FOUNDATION PLAN - AREA 4
2	H-3-20195	STR. CONC. - FOUNDATION PLAN - AREA 3
1	H-3-20150	DRAWING LIST

REFERENCE DRAWINGS

NEXT USED ON