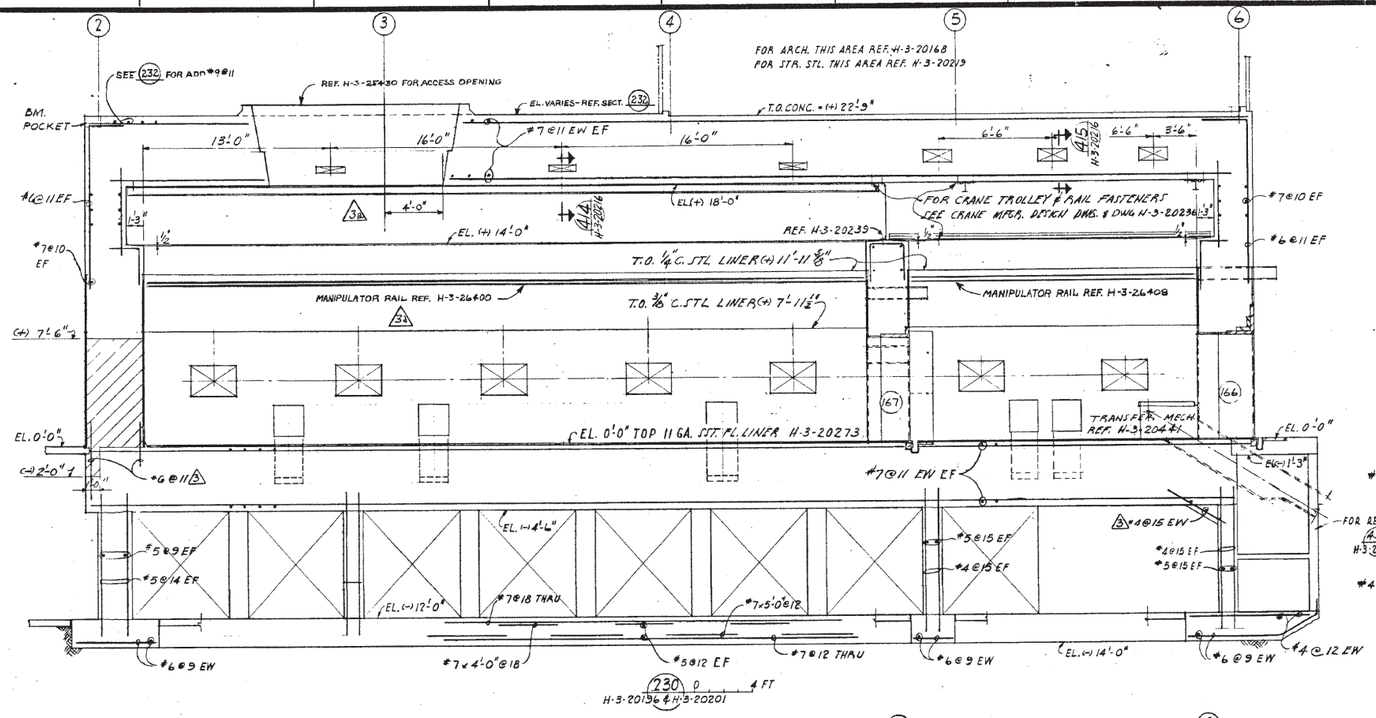

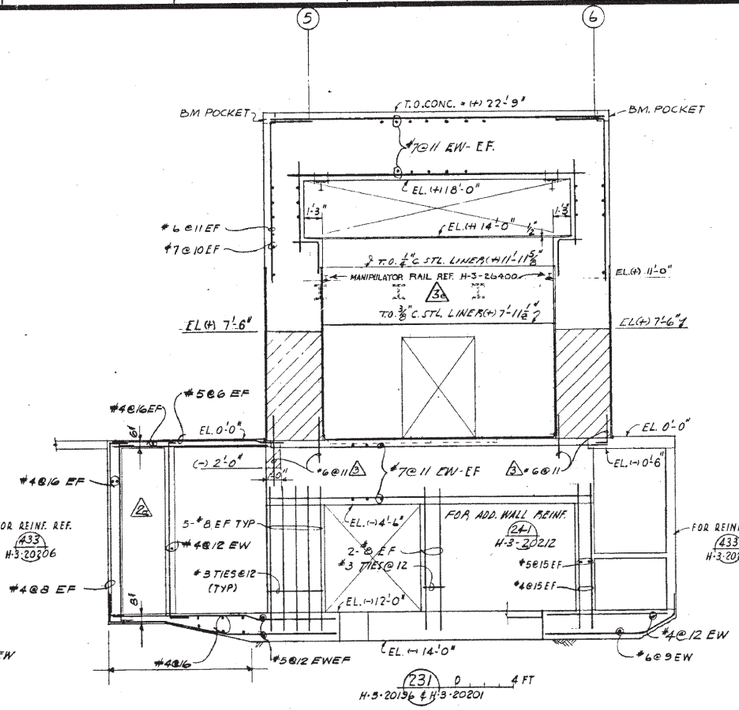

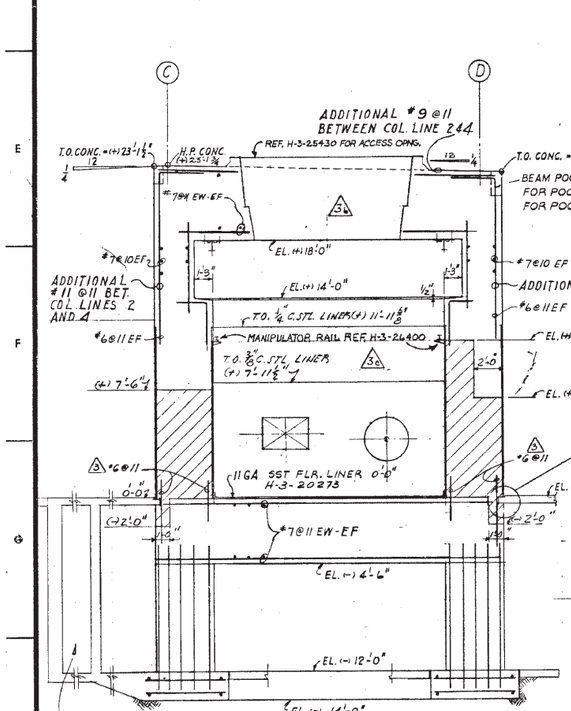

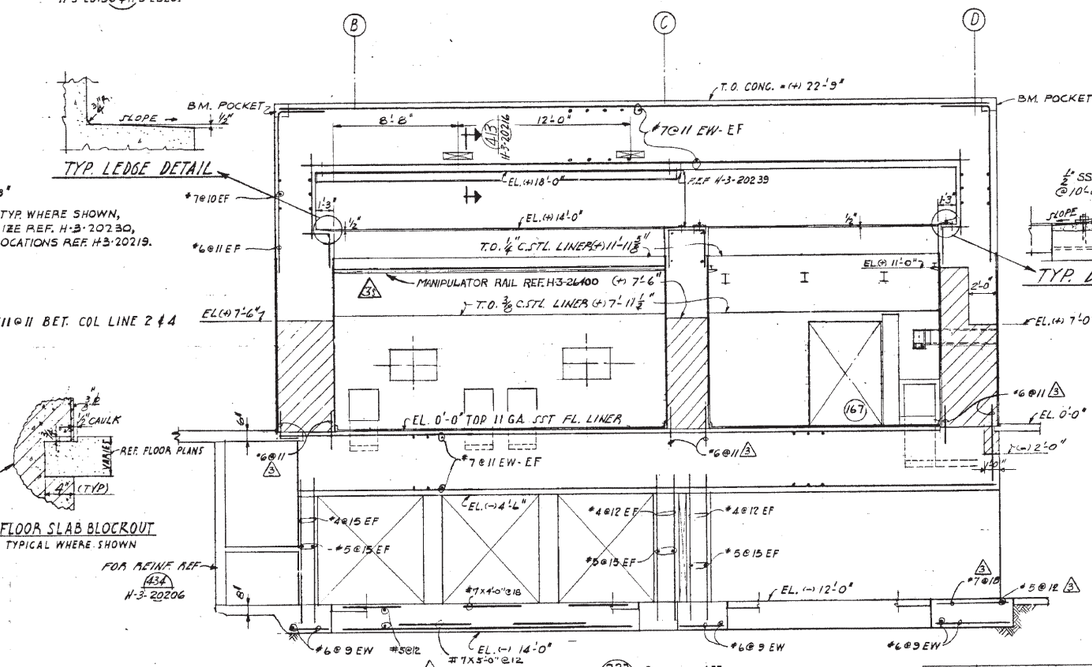

FLOOR SLAB BLOCKOUT
TYPICAL WHERE SHOWN

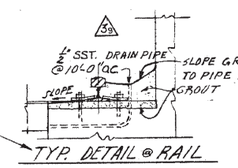

TYP. DETAIL @ RAIL

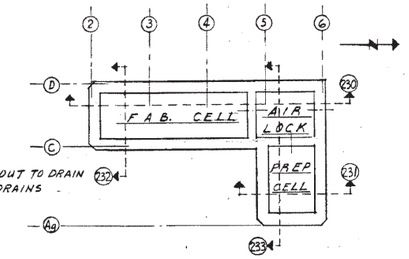

KEY PLAN - HOT MET. CELLS

▨ - HIGH DENSITY CONCRETE

NOTE.

INSTALL AN ANCHOR PLATE PER DETAIL - H-3-20285 (591) IN CEILING OVER FAB. & PREP. CELL SHIELDING DOORS FOR DOOR LIFTING

REF. H-3-20616 FOR ALL PENETRATIONS BETWEEN ELEV. 0'-0" AND (+) 12'-0"

H-3-20211 SHEET — REV. 3

REF. NO.	DWG. NO.	DRAWING TITLE
	H-3-20616	WALL LINER ELEVATIONS
	H-3-20206	STR. CONC. - SECTIONS & DETAILS
	H-3-20273	11 GA. SST. FLOOR LINER
	H-3-20239	DOOR SHIELDING
	H-3-20230	BEAM POCKET DETAILS
	H-3-20219	STRUCTURAL STL. BEAMS
	H-3-20201	STRUCTURAL CONC. PLAN @ 0'-0"
	H-3-20196	STRUCTURAL CONC. PLAN @ (-) 12'-0"
	H-3-20150	DRAWING LIST

REFERENCE DRAWINGS

..EXT USED ON

NO.	DESCRIPTION	REV. BY	APP'D BY	FOR	DATE
3	G-6. CHECKED FOR AS-BUILT DET. ZN. E-10 (N) ADDED STL. ZN. ZNS. F-2, B-3, B-11, E-6 (G) REV. E-2, G-6 & F. ADDED MANIP. REF. F-8, F-9, G-7, C-1, C-10, C-12, C-8 (B.S.) ADDED ROOF ACCESS ZN A-3, F-8, F-9, G-7, C-1, C-10, C-12, C-8 ADD REF. STEEL G-1, G-3, F-5	DW W. 11-10-65			
2	b. ADDED NOTE (H-1) SECT. B3 (C-9) a. ADDED TUNNEL REINF	LRL 6-10-63	NCL Rino		
1	ISSUED CONST. JTY. - EFFECT 230, 231, 233				

CHECK PRINT	COMMENT PRINT
ISSUE NO. 1	DATE 3/26/62
ISSUE NO. 3	DATE 2/11/66
SCALE	SHOWN
DRAWN	R. J. HINES
CHECKED	
ISSUED	
DES. ENG.	
PROJECT	CAH-816
INST. NO.	12479
CLASSIFIED BY	
DATE	2/11/66

APPROVED FOR CONST.	BY	FOR	DATE	REV.

APPROVED FOR PURCHASE	BY	FOR	DATE

APPROVED FOR DESIGN	BY	FOR	DATE

CLASSIFICATION: NONE

U. S. ATOMIC ENERGY COMMISSION
HANFORD ATOMIC PRODUCTS OPERATION
GENERAL ELECTRIC

STRUCTURAL CONCRETE
HOT METALLURGICAL CELLS
SECTIONS & DETAILS - AREA 4

FUELS RECYCLE PILOT PLANT

BLDG. NO. 324 | INDEX NO. 0901

DWG. NO. H-3-20211 | SHT. NO. — | SHEETS —